




00255054

RECEIVED

JUN 8 1983

COLO. OIL & GAS CONS. COMM.

R. 52 W

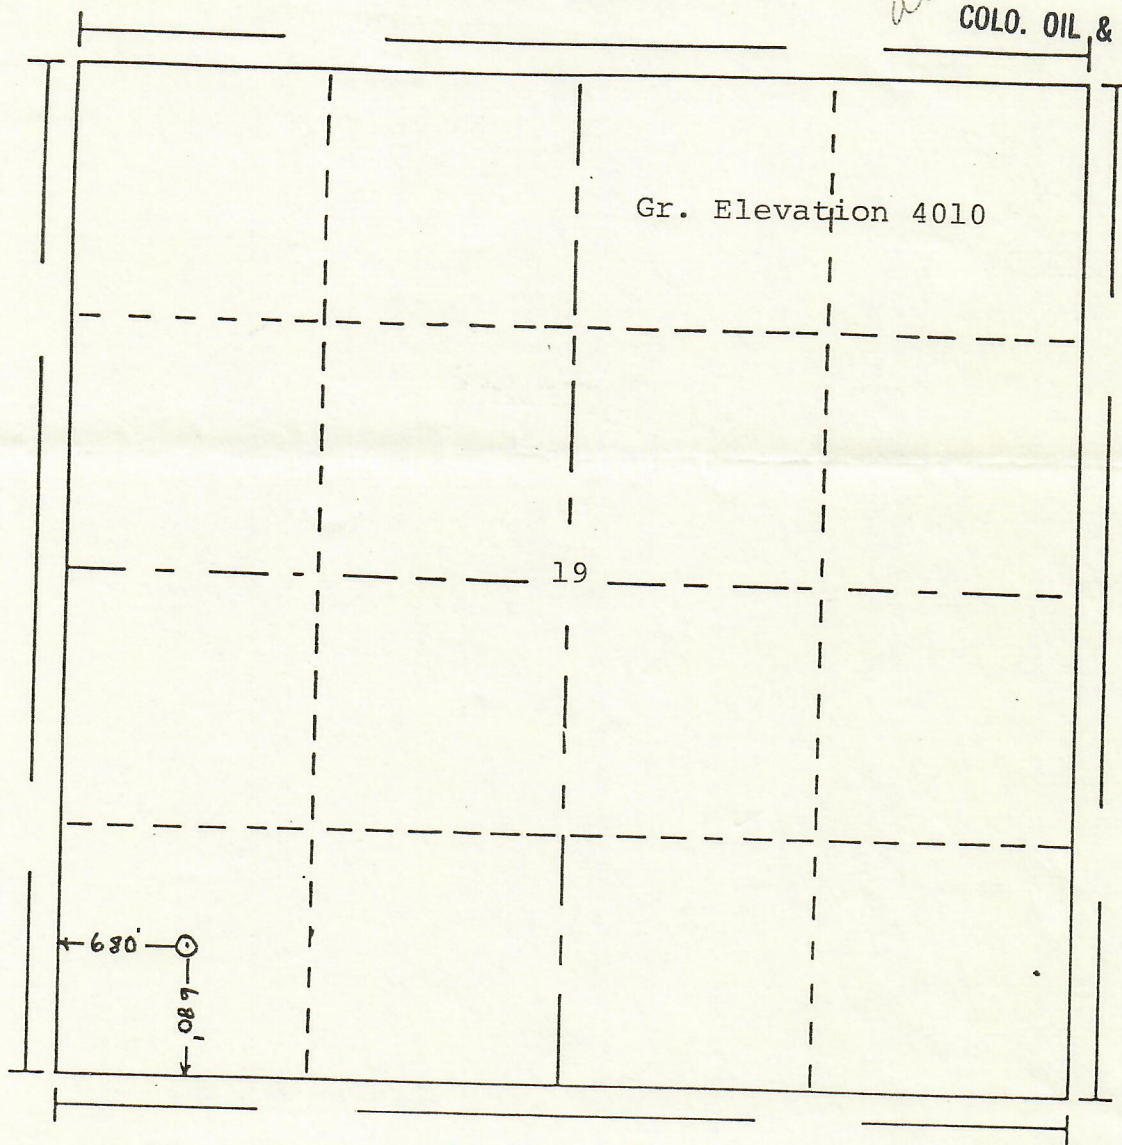

T. 9 N

Scale... 1" = 1000'

Powers Elevation of Denver, Colorado
has in accordance with a request from Mr. Gear
for Gear Drilling
determined the location of #1 Pedroni
to be 680fsl, 680fwl Section 19 Township 9 N
Range 52 W of the 6th Principal Meridian
Logan County, Colorado

I hereby certify that this plat is an
accurate representation of a correct
survey showing the location of
#1 Pedroni

5-1-83

Billy G. Holloway
Licensed Land Surveyor No. 2853
State of Colorado

