


RECEIVED  
FEB 27 1986  
C.O.L. OIL & GAS CONS. COMM

CERTIFICATE OF SURVEY  
for  
Allison Bros, Drilling, Wingfield Exploration  
Logan County, Colorado



00264659

T 9N R54W 6PM.

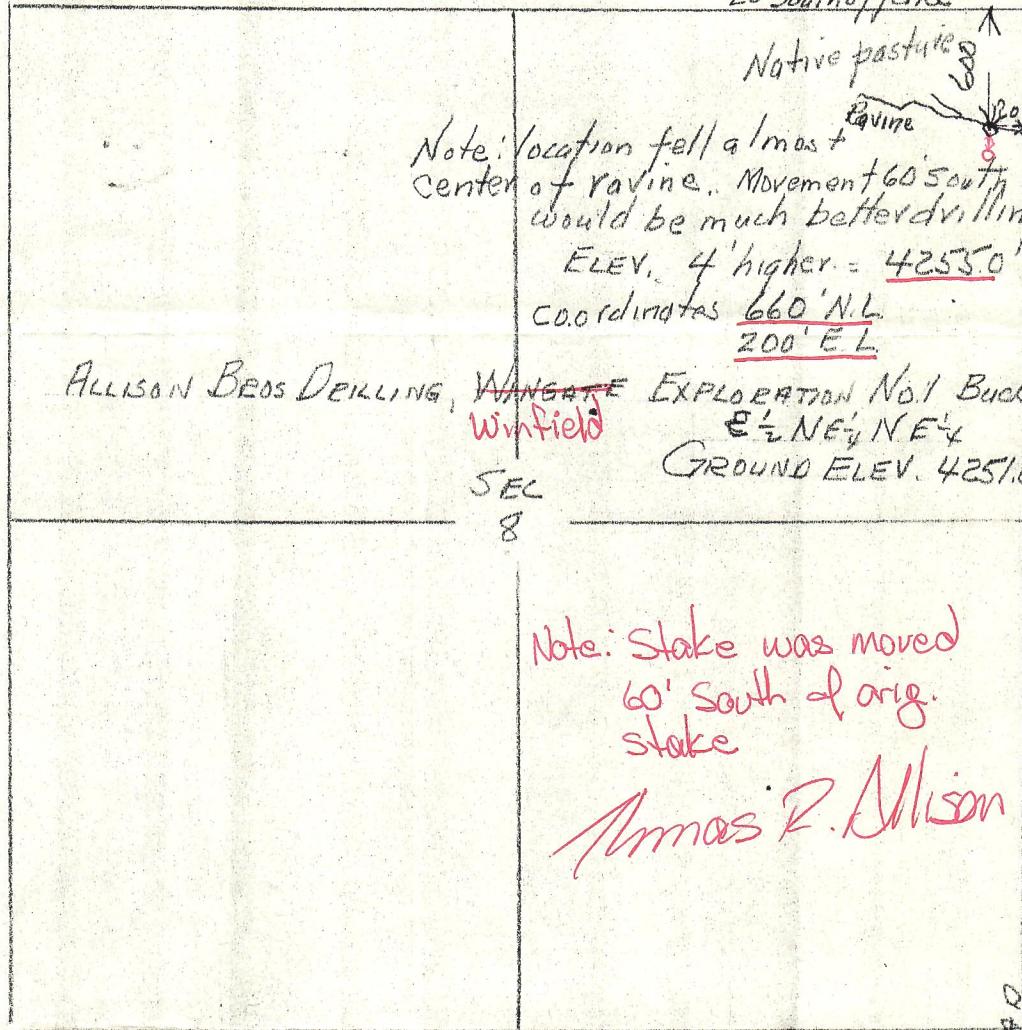

I hereby certify that the above plat is an accurate representation of a correct survey showing the location of Allison Bros. Drilling, Wingfield Exploration No.1 Buckleiter Oilwell in  $E\frac{1}{2}NE\frac{1}{4}NE\frac{1}{4}$  Sec. 8 T9N R54W 6PM. The elevation of the ground at the stake is 4251.0 feet above sea level from U.S.G.S. Bench Mark.

Fort Morgan, Colorado  
Feb. 19, 1986

*Recall J. Costane*  
Registered Professional Engineer  
State of Colorado