



00205305

CERTIFICATE OF SURVEY

for


Michal T. Cowen-Dean L. Cummins
Weld County, Colorado

RECEIVED

JAN 28 1969

COLO. OIL & GAS CONS. COMM.

T7N R60W 6PM

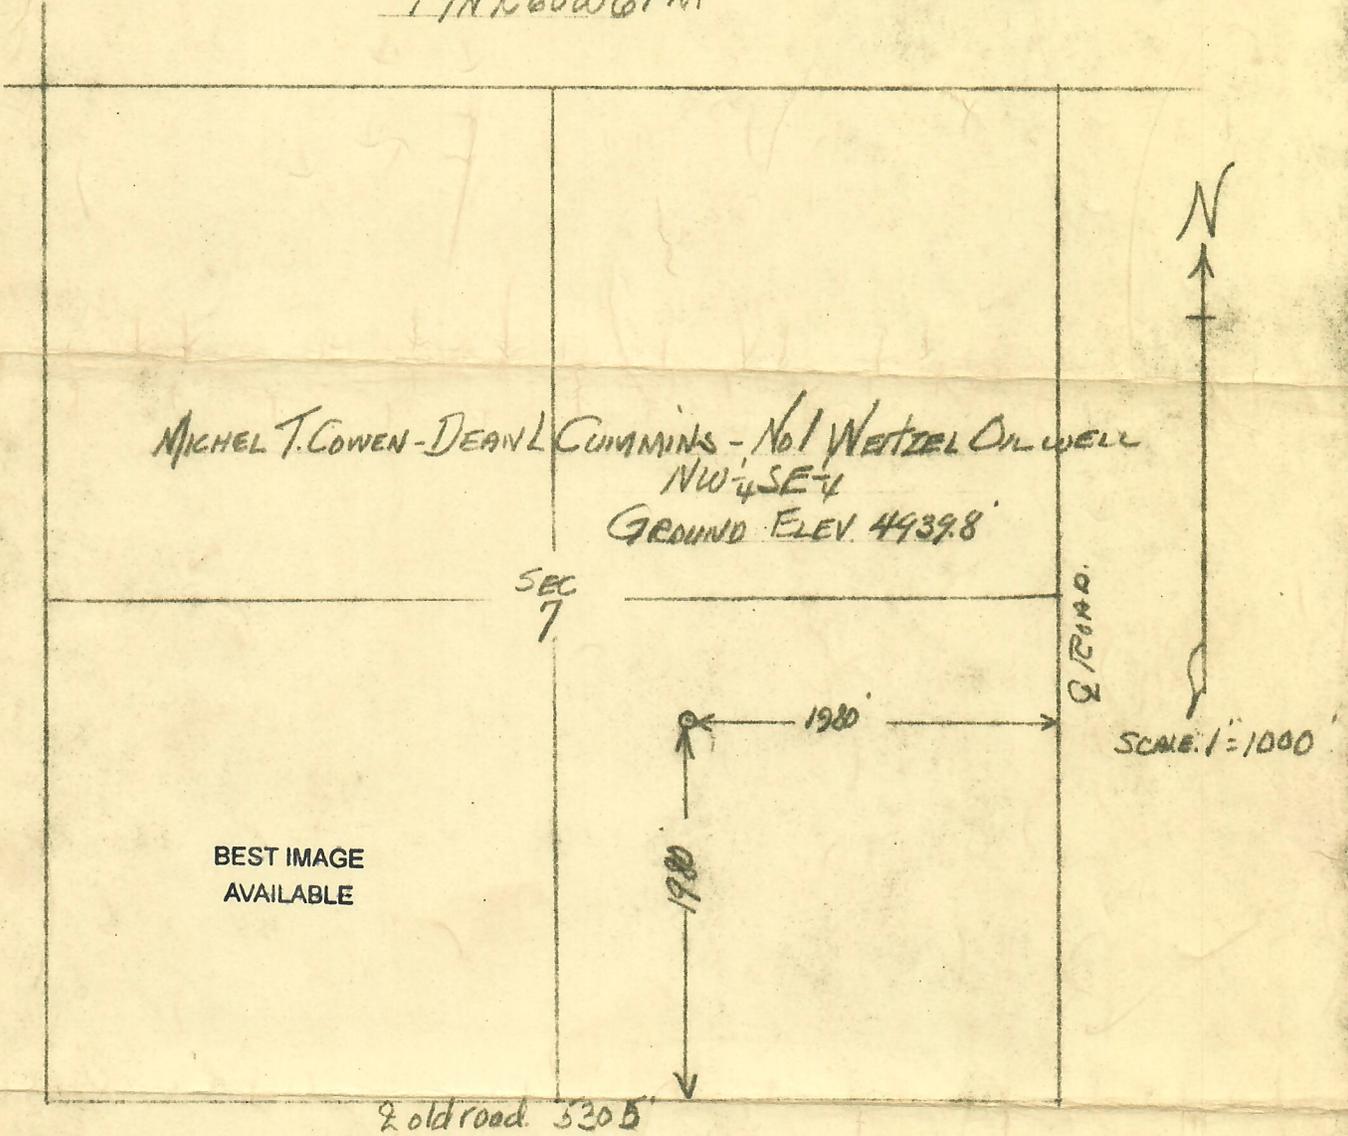

I hereby certify that the above plat is an accurate representation of a correct survey showing the location of Michal T. Cowen-Dean L. Cummins- No. 1 Weitzel Oilwell in NW 1/4 SE 7 Sec. 7 T7N R60W 6PM. The elevation of the ground at the stake is 4939.8 feet above sea level from U.S.C.&G. Bench Mark.

Fort Morgan, Colorado
Dec. 28, 1968

Cecil J. Osborne
Registered Professional Engineer
State of Colorado

68-550