



OIL AND GAS CONSERVATION COMMISSION OF THE STATE OF COLORADO

MAR 22 1966

66-94

NOTICE OF INTENTION TO DRILL

OIL & GAS CONSERVATION COMMISSION


INSTRUCTIONS:

A notice of intention to drill a well shall be filed in duplicate on all Federal and Patented lands, and in triplicate on all State lands. Do not begin operations until approved copy has been received. It is mandatory that the proposed location comply with all rules and regulations of the Commission. Locate well on section grid in proper location, and indicate extent of lease. Unless operations are commenced within 180 days after the date of approval hereof, this approval to drill will become null and void.

Name of Operator PETROLEUM, INC. Phone No. 222-9429
Address 860 Petroleum Club Bldg. City Denver State Colorado 80202

How is liability secured: Well Bond (Attached) []; Blanket Bond [x]; Waiver [] (Check one)

Lease Name Buchleiter
Well No. 1
Field Name Wildcat [x]
County LOGAN

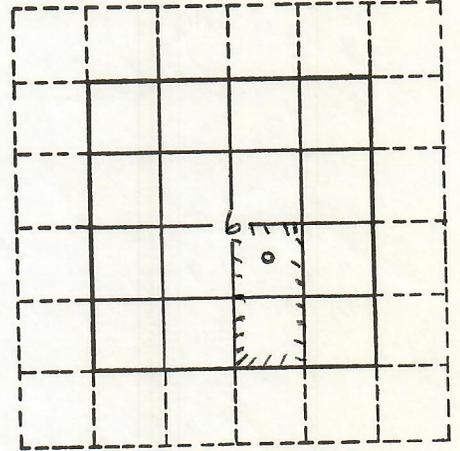

Location C NW SE Section n 6 Township 9N Range 54W Meridian 6th P.
1935 feet from S Section line and 1965 feet from E Section Line

The well is located on: Patented land [x] State land [] Federal land []

The well is located within a spaced area: Yes [] No [x]

Distance from proposed location to nearest property or lease line 645 feet.
Distance from proposed location to nearest drilling unit line [] feet.

Objectives: 'J' Formation Depth 5425' Estimate; Formation Depth Estimate

Proposed length of surface casing 150 feet.

REMARKS:

8-5/8" csg. @ 150' w/100 sx.

Table with columns for names (DVR, WRS, HHM, JAM, FJP, JJD, FILE) and a check number (5427) with date (3/22/66).

I/We hereby swear (or affirm) that the statements herein made are a full and correct report.

APPROVED:

Date MAR 22 1966
D. V. Rogers
Director

Company PETROLEUM, INC. Date 3-18-66
Address 860 Petroleum Club Bldg. Phone No. 222-9429
By [Signature] Title Attorney in Fact

94 Permit No. 66-94