




RECEIVED
AUG 16 1955

AUG 16 1955

OIL & GAS
CONSERVATION COMMISSION

T9N R54W 6 P.M.

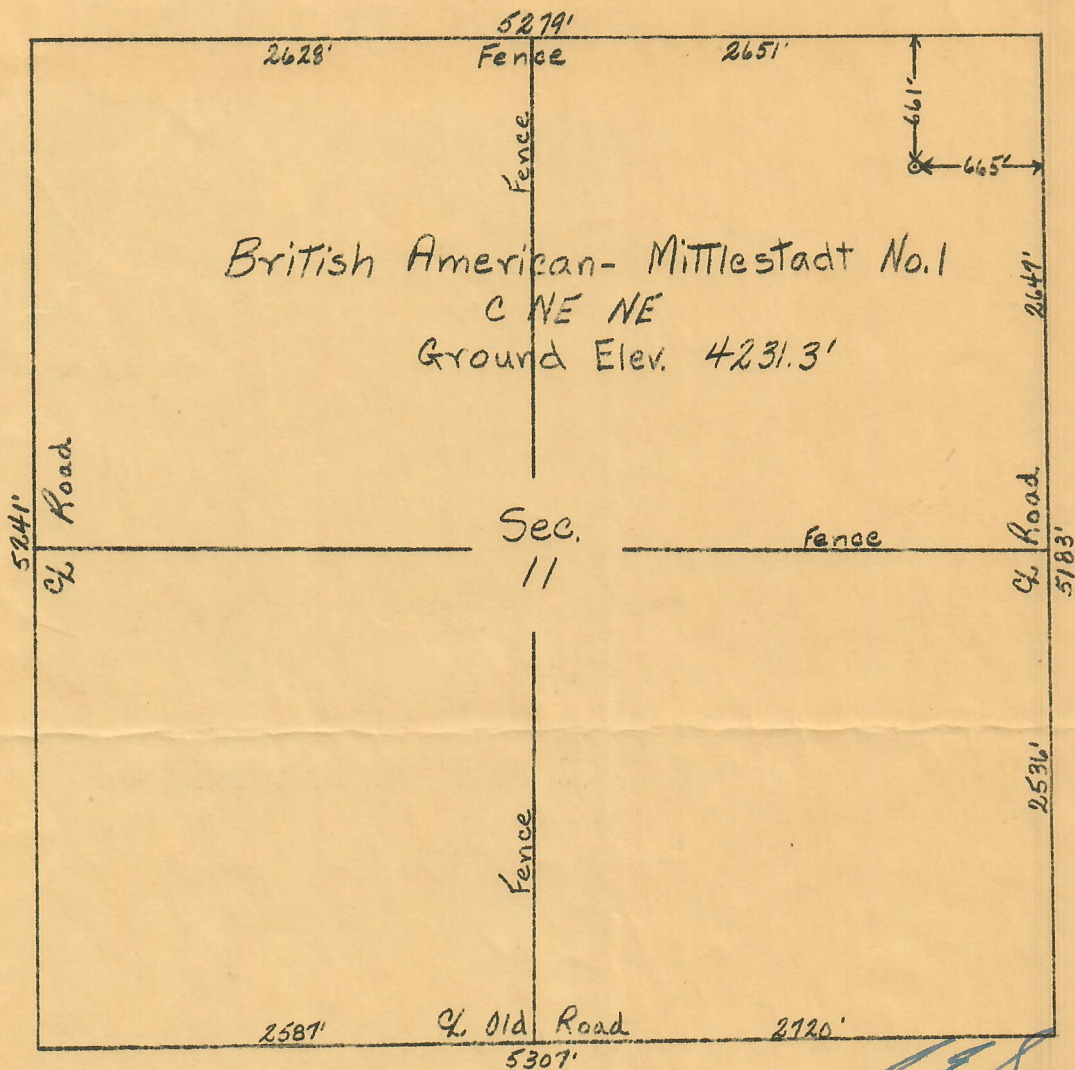

Scale 1" = 1000'

Fort Morgan, Colorado
June 26, 1955

Registered Professional Engineer
State of Colorado

Sheldon