




00264355

RECEIVED

'DEC 16 1970

COLO. OIL & GAS CONS. COMM.

R. 52W

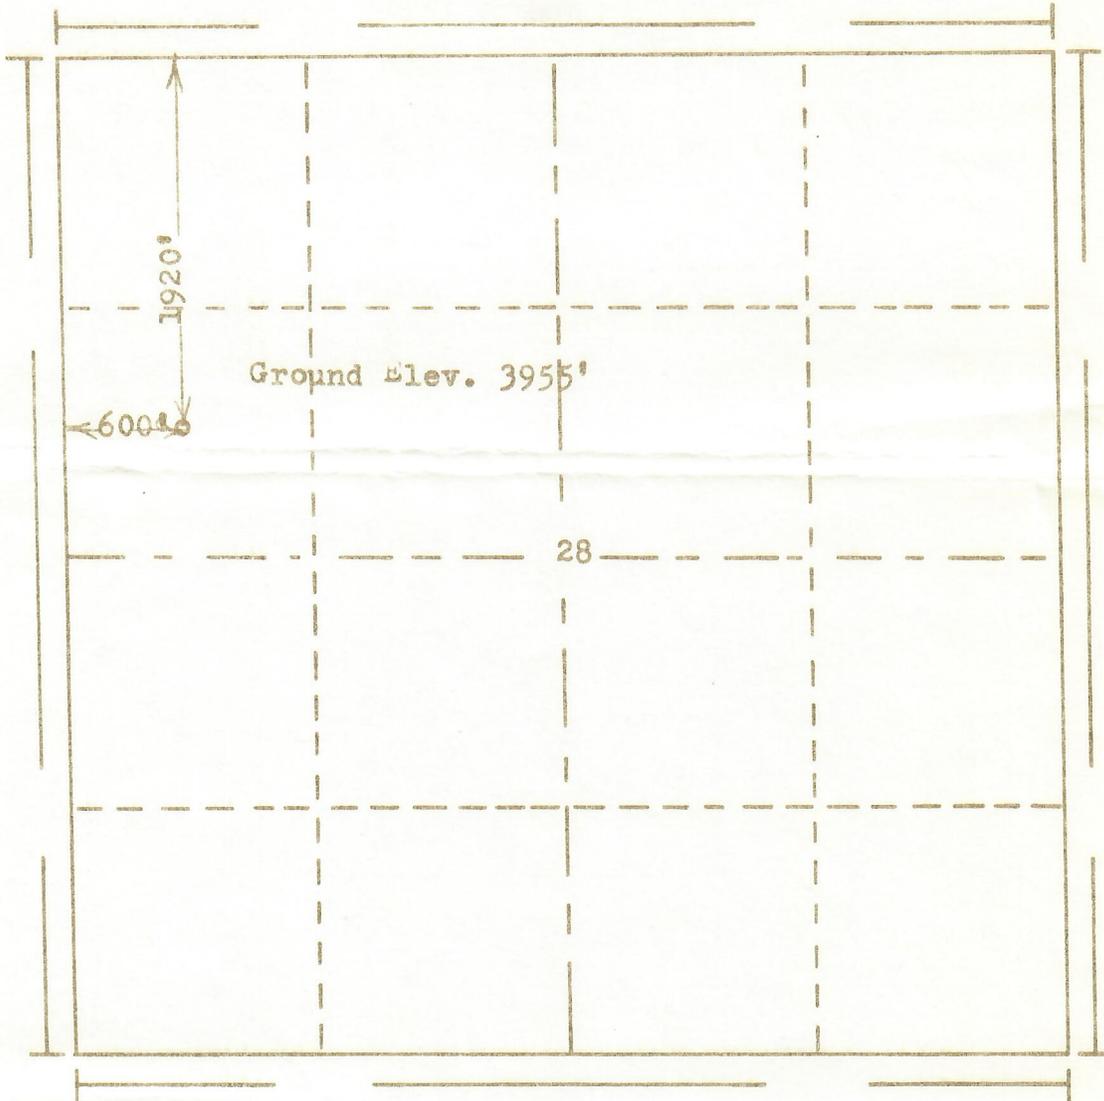

Scale... 1" = 1000'

Powers Elevation Company, Inc. of Denver, Colorado has in accordance with a request from Mr. Murphy for Miami Oil Producers, Inc. determined the location of No.1 Giacomini to be 1920'FN & 600'FW Section 28 Township 9N Range 52W of the 6th Principal Meridian Logan County, Colorado

70-724

I hereby certify that this plat is an accurate representation of a correct survey showing the location of

Date. 12-8-70

Eric J. Holloway

Licensed Land Surveyor No. 2853
State of Colorado