

CERTIFICATE OF SURVEY
for
Sundance Oil Co.
Logan County, Colorado




RECEIVED

SEP 25 1969

COLO. OIL & GAS CONS. COMM.

T9N R54W 6PM

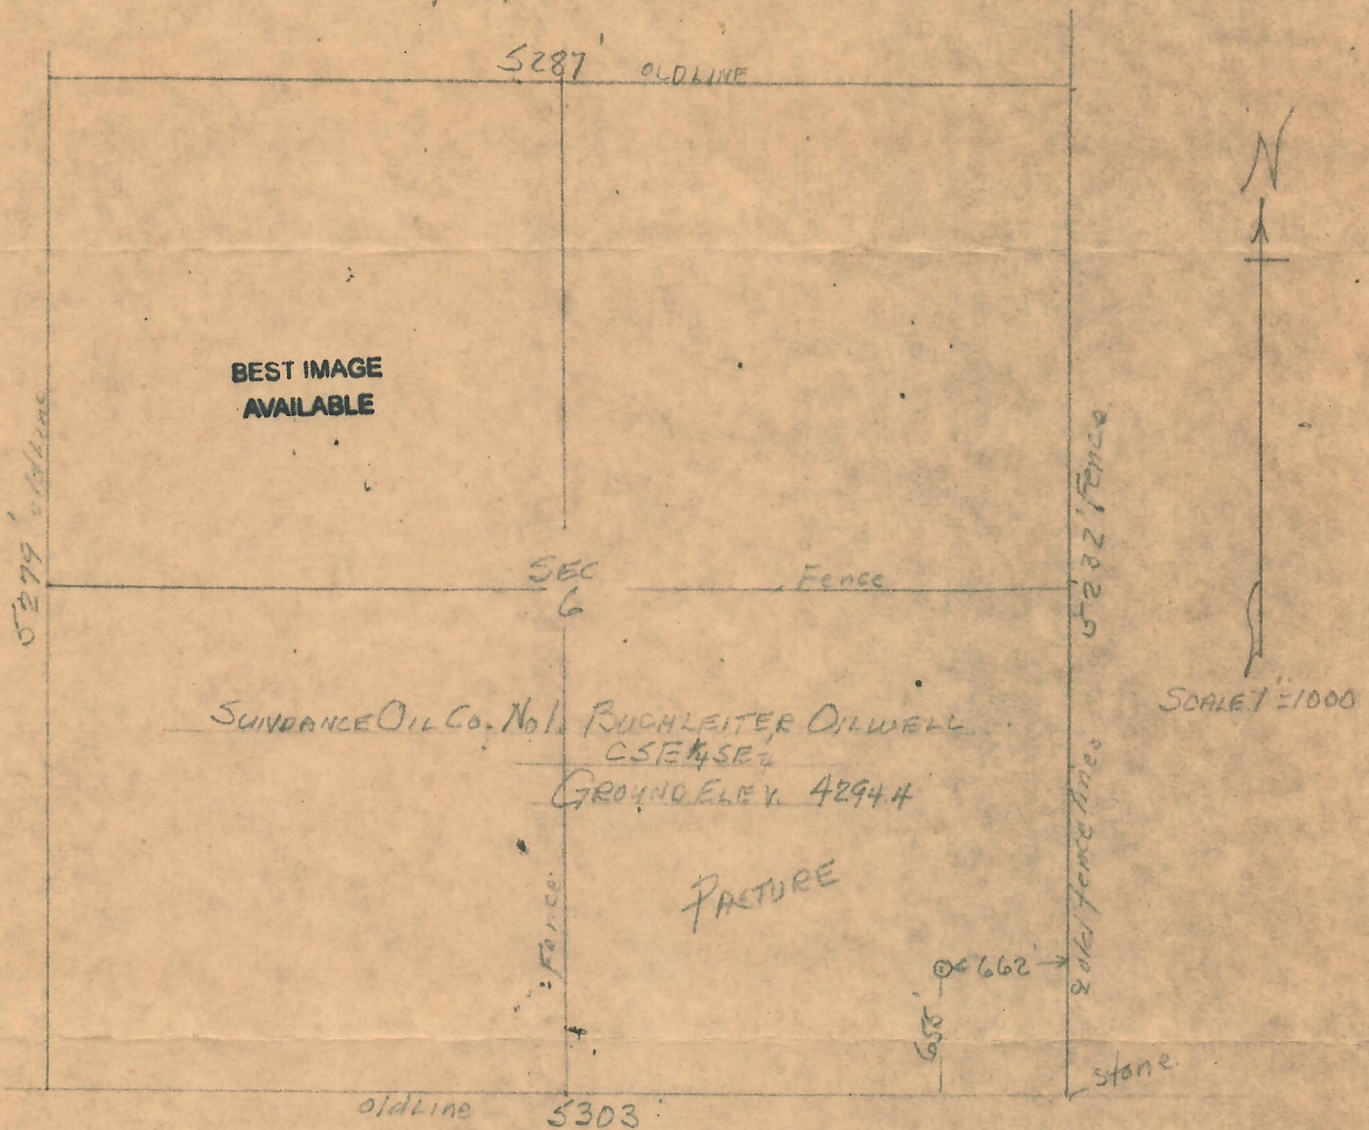

I hereby certify that the above plat is an accurate representation of a correct survey showing the location of Sundance Oil Co.-No. 1 Buchleiter Oilwell in C 5E 1/4 SE 1/4 Sec. 6 T9N R54W 6PM. The elevation of the ground at the stake is 4294.4 feet above sea level from U.S.C. & G. Bench Mark.

Fort Morgan, Colorado
Sept. 18, 1969

Carol J. Osborne
Registered Professional Engineer
State of Colorado