


Well Name: GUTTERSEN 42-23

VERTICAL, ORIGINAL HOLE, 11/6/2019 2:01:16 PM

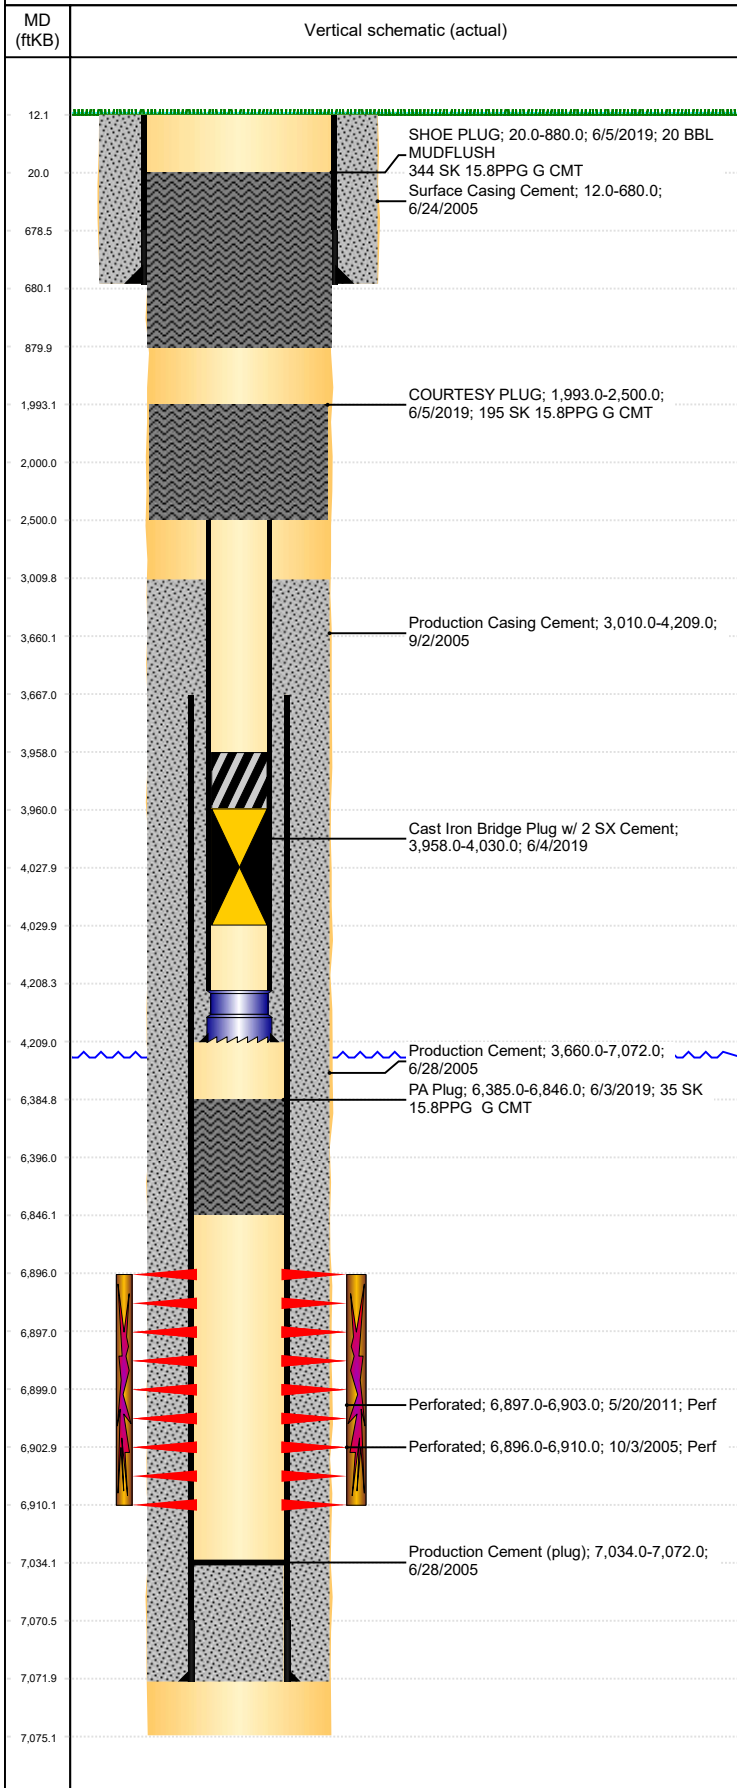

Well Header									
API 05-123-20804		Business Unit DJ BASIN			District 15		Well Config VERTICAL		
KB - GL / MSL (ft... 12.00		Spud Date 6/23/2005		P & A Date		Well Production Status PA			SoRT Yes
Comment CASING REPAIR 2 7/8" TUBING WITH NOTCHED COLLAR SET AT 4209'									
PRODUCTION CSG INFO MISSING IN FILE, JOINTS PULLED AND SET NOT AVAILABLE									
Surface Location (Congressional)									
Qtr 3 SE	Qtr 4 NE	Section 23	Twnshp 3	Twnshp... N	Range 64	Rng E/... W	Actual Latitude (°) 40.21259696	Actual Longitude (°) -104.51133337	
Wellbore Sections									
Section Des		Size (in)			Act Top, MD (ftKB)		Act Btm, MD (ftKB)		
SURFACE		12 1/4			12		680		
PRODUCTION		7 7/8			680		7,075		
Casing Strings									
Csg Des		Run Date	OD (in)	Wt/Len (lb/ft)	Grade	Top, MD (ftKB)	MD (ftKB)		
Surface		6/24/2005	8 5/8	24.00	J-55	12.0	680.0		
Production		9/2/2005	2 7/8	6.50	N-80	12.0	4,209.0		
Production		6/28/2005	4 1/2	11.60	N-80	12.0	7,072.0		
Cement									
Des			Start Date		Top (ftKB)		Btm (ftKB)		
Surface Casing Cement			6/24/2005		12.0		680.0		
Production Cement			6/28/2005		3,660.0		7,072.0		
Production Casing Cement			9/2/2005		3,010.0		4,209.0		
PA Plug			6/3/2019		6,385.0		6,846.0		
COURTESY PLUG			6/5/2019		1,993.0		2,500.0		
SHOE PLUG			6/5/2019		20.0		880.0		
Zone Statuses									
Zone Name		Status Date	Status	Fluid Type	Job			Prod Method	
CODELL		3/9/2017	PR						
CODELL		6/3/2019	P&A		PLUG AND ABANDON, 5/31/2019 07:00				
Perforation Data									
Linked Zone		Bnch/Stg	Entered Shot Total	Top (ftKB)		Btm (ftKB)		Date	
CODELL, ORIGINAL HOLE			56	6,896.00		6,910.00		10/3/2005	
CODELL, ORIGINAL HOLE			24	6,897.00		6,903.00		5/20/2011	
Stimulation Intervals									
Zone			Start Date		Top (ftKB)		Btm (ftKB)		
CODELL, ORIGINAL HOLE			10/5/2005		6,896.0		6,910.0		
CODELL, ORIGINAL HOLE			6/1/2011		6,896.0		6,910.0		
Other In Hole									
Run Date		Des			OD (in)	Top (ftKB)	Btm (ftKB)		
6/4/2019		Cast Iron Bridge Plug w/ 2 SX Cement			2.441	3,958.0	4,030.0		
Logs									
Date		Type				Top, MD (ftKB)		Btm, MD (ftKB)	
6/27/2005		DENSITY/INDUCTION				6,450.0		7,075.0	
8/9/2005		CBL/CCL/GR				2,190.0		6,894.0	
9/20/2017		GYRO				0.0		6,800.0	
Plug Back Total Depths									
Date		Type		Com				Depth (ftKB)	
8/9/2005		CEMENT PLUG		DEPTH LOGGER ON CBL				6,899.0	
5/19/2011		FILL		C/O				7,034.0	