


123-13933
FAX 850-0175

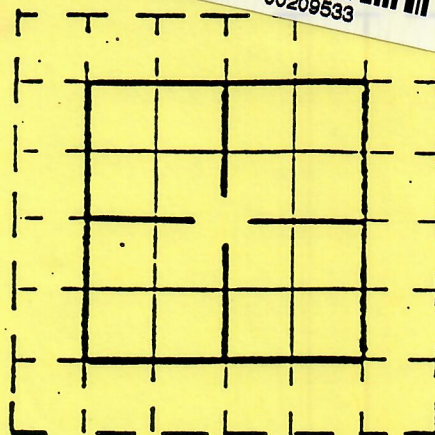

VERBAL REQUEST



NOTICE OF INTENT TO DRILL _____
NOTICE OF INTENT TO ABANDON X
OTHER _____

COMPANY Tindall Expl ADDRESS _____
BY Lee Tucker PHONE NO. 850-7272 EXT. _____
WELL NO. 5 LEASE Lind
COUNTY Weld FIELD Gemini DRLG UNIT _____

LOCATION NESE SEC 13 TWP 7N RNGE 59W MERIDIAN _____
_____ ft. from N or S Sec. Line, and _____ ft. from E or W Sec. Line

ESTIMATED DATE OF WORK _____ ESTIMATED TIME _____

DETAILS OF PLAN OF WORK: T.D. 4/20 6644 FORMATION D sand

SURFACE CASING 8 5/8 @ 22 7/8" perfs 6503-6526

- ① Set CIBP @ \pm 6450 \pm dump bail 2-3 sx on CIBP
- ② Cut 4 1/2" CSG @ free point, load hole
- ③ Set 40sx Cement plug from 450'-550'
- ④ Set 100' Cement plug (min 40sx) from 175'-275'
- ⑤ Set 10sx cement top plug @ surface
- ⑥ Cut CSG 4' below G.L, weld plate ⑦ Restore location


BONDING STATUS: PLUGGING _____ SURFACE _____ OTHER _____

Is surface owner also mineral owner? _____

ACREAGE LEASED SURROUNDING DRILLSITE _____

APPROVED BY: James Robbin DATE 5/31/96

Notify Ed Binkley 48 hrs prior to
starting work @ (970) 842-4465

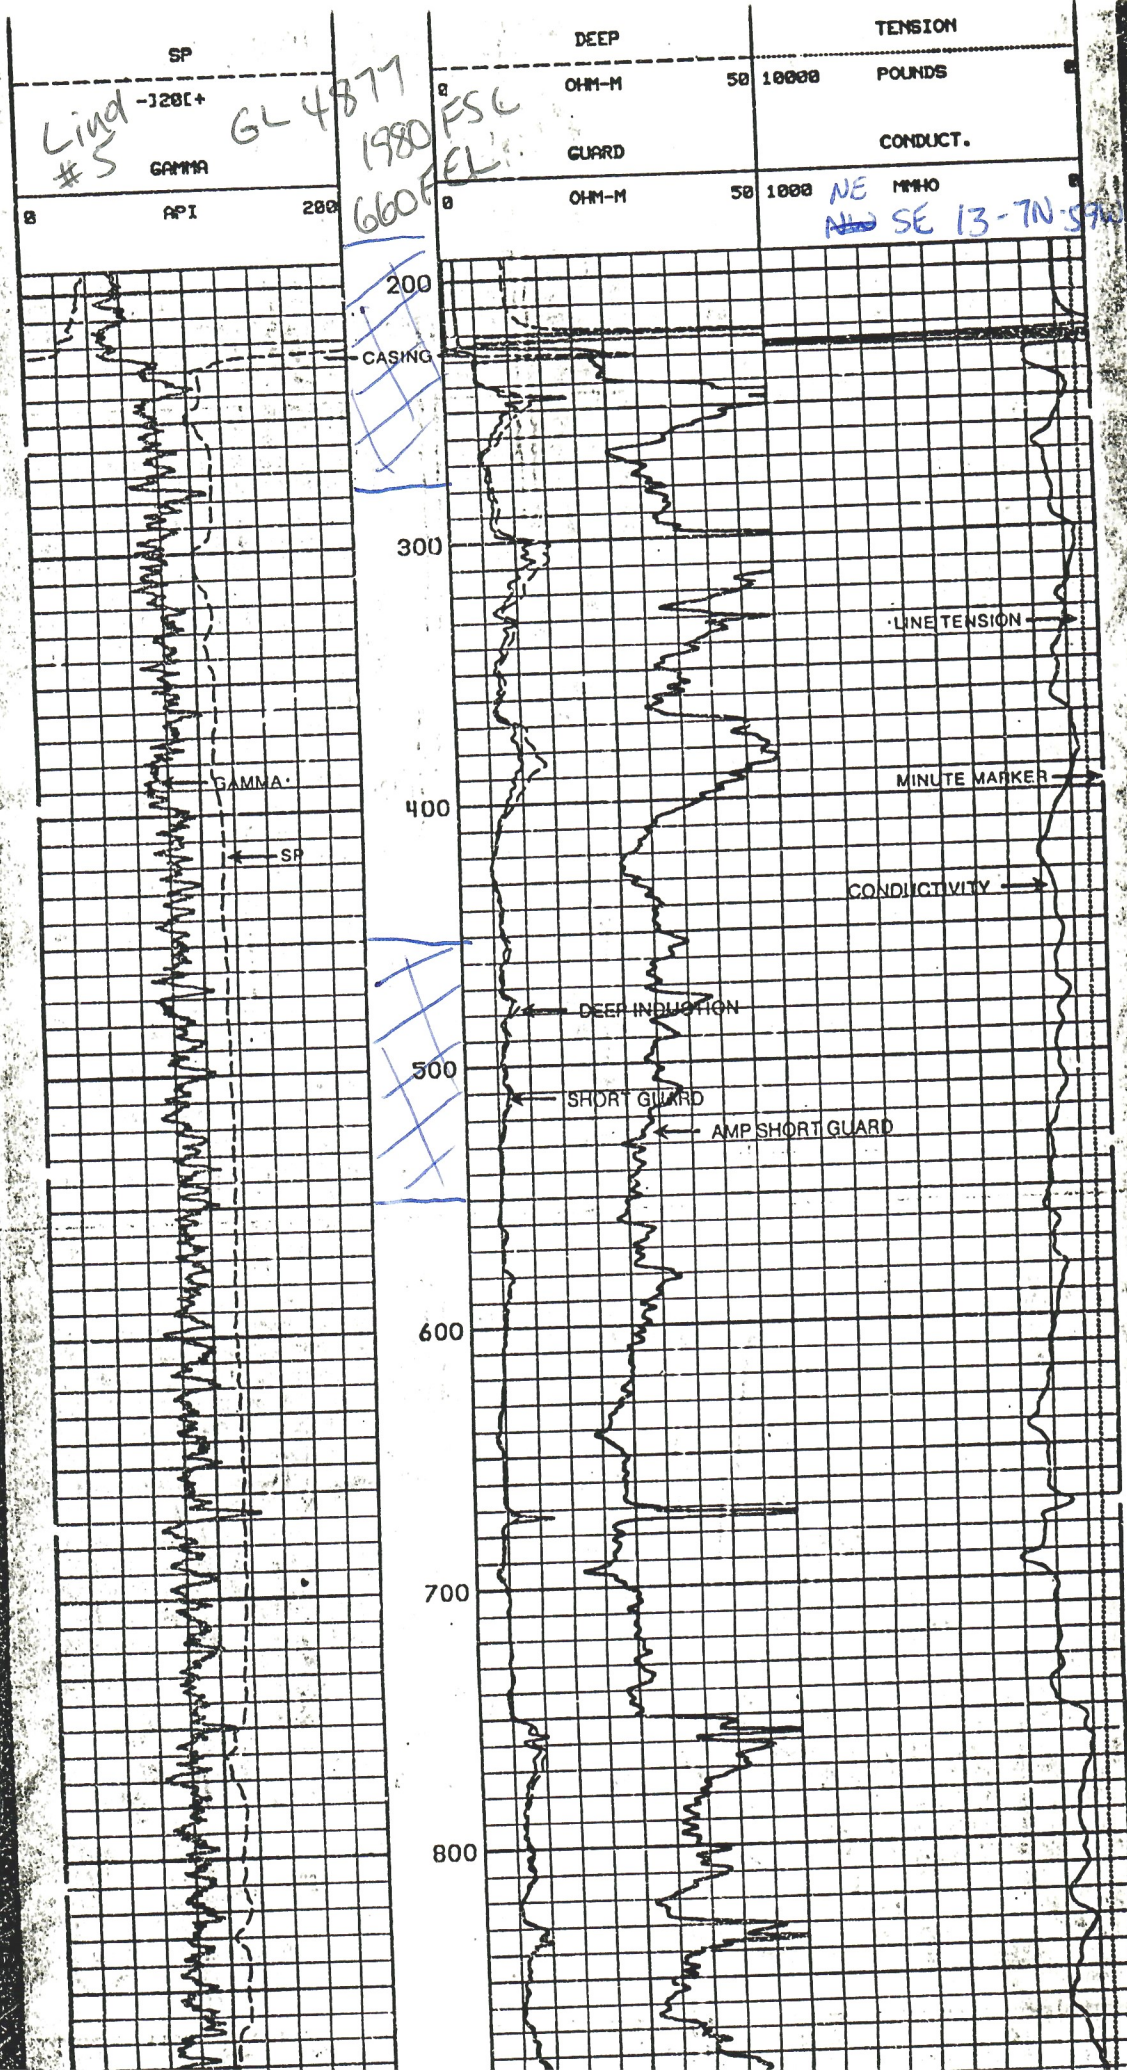

D Sand
 perf
 6503
 26
 878
 2225
 4 1/2
 @
 6644

59W

58W

