


SURVEYOR'S CERTIFICATE

I, R. C. Moon, a Registered Land Surveyor in the State of Colorado, do hereby certify that this map was made from the data taken during an actual survey under my direct supervision on August 15th 1988, and that it correctly shows the location of THE RAY SELBE No 1.

R.C. Moon

R.C. MOON L.S. No. 13224

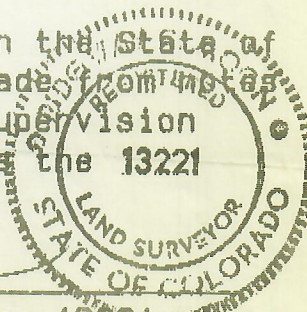

NOTICE: "According to Colorado law you must commence any legal action based upon any defect in this survey within six years after you first discover such defect. In no event may any action based upon any defect in this survey be commenced more than ten years from the date of the certification shown hereon."



D & D Inc.

A PROFESSIONAL LAND SURVEYING AND PLANNING CO.
P.O. Box 779008, Steamboat Springs, Colorado 80477
(303) 879-8719

SARITA ENERGY CO.
PLAT OF DRILLING LOCATION
LOCATED IN SECTION 7, T6N, R85W, of
THE 6TH P.M., ROUTT COUNTY, COLO.