

25 6N 86W




00544925

107-05041

 Budget Bureau No. 42-R-355.3.
 Approval expires 12-31-55.
U. S. LAND OFFICE DenverSERIAL NUMBER 056134-A

LEASE OR PERMIT TO PROSPECT

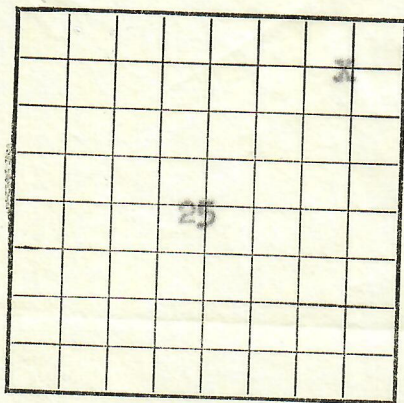

LOCATE WELL CORRECTLY

UNITED STATES

DEPARTMENT OF THE INTERIOR

GEOLOGICAL SURVEY

BEST IMAGE
AVAILABLE

LOG OF OIL OR GAS WELL

Company Arrowhead Exploration Co. Address 219 Mile High Center, Denver
 Lessor or Tract McBride Field Wildcat State Colorado
 Well No. 1 Sec. 25 T. 6N R. 86W Meridian 6th PM County Routt
 Location 660 ft. N. of 660 ft. E. of E. Line of Sec. 25 Elevation 6916 Gr.

The information given herewith is a complete and correct record of the well and all work done thereon so far as can be determined from all available records.

Signed

Frank I. Hiestand
 Title Petroleum Engineer
Date September 10, 1957

The summary on this page is for the condition of the well at above date.

Commenced drilling May 12, 1956 Finished drilling November 30, 1956

OIL OR GAS SANDS OR ZONES

(Denote gas by G)

No. 1, from None to _____ No. 4, from _____ to _____
 No. 2, from _____ to _____ No. 5, from _____ to _____
 No. 3, from _____ to _____ No. 6, from _____ to _____

IMPORTANT WATER SANDS

No. 1, from None to _____ No. 3, from _____ to _____
 No. 2, from _____ to _____ No. 4, from _____ to _____

CASING RECORD

Size casing	Weight per foot	Threads per inch	Make	Amount	Kind of shoe	Cut and pulled from	Perforated		Purpose
							From—	To—	
10 3/4	32.75	8 rd	Spring	92'	collar				surface
8 5/8	24								
7									

MUDDING AND CEMENTING RECORD

Size casing	Where set	Number sacks of cement	Method used	Mud gravity	Amount of mud used
10 3/4	92'	unknown	circulated	heavy gel	mudded to surface
8 5/8	1207'	none	mudded	heavy gel	mudded to top
7	2996'	none	mudded	heavy gel	mudded to 1200'

PLUGS AND ADAPTERS

Heaving plug—Material none Length _____ Depth set _____
 Adapters—Material _____ Size _____

SHOOTING RECORD

none

DATES

Rock pressure, lbs. per sq. in. _____

FORMATION RECORD

LEON—