

107-05105

12


#1 Belle Dennis

NWSW 8-6N-86W



99999999


LOG OF WELL

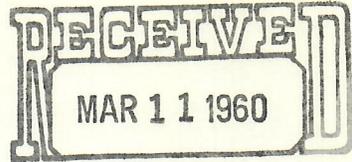

SHEET No. _____

OIL & GAS
CONSERVATION COMMISSION
Well No. _____

District	Owner	Farm			DEPTH CORES TAKEN	REMARKS
FORMATION	BOTTOM	AMOUNT	COLOR	HARD OR SOFT		
				#		
<p>Texas Production Company <u>Belle Dennis #1</u> Toy Creek Field, Routt County, Colo. 410' E. of S. line and 668' E. of W. line of NW 1/4 SW 1/4 Sec. 8, T. 6 N., R. 86 W.</p> <p>Commenced drilling: April 30, 1926. Completed drilling: May 29, 1926.</p> <p>Initial production - dry - Abandoned.</p> <p>CASING RECORD: 12 1/2" 50# 55'0" All pulled. 8 1/2" 38# 1200'0" " " 6 1/2" 28# 2534'0" " "</p>						
20	20		Clay, yellow,	soft		Some water
28	8		Gravel			
1200	1172		Shale, blue,	soft		Show of gas at 1960
1265	65		Shale, gray,	soft		" " " " 2130
2530	1255		Shale, blue,	soft		
2560	30		Shale, gray,	soft		Slight show oil - 2760
2620	60		Shale, black,	soft		" " " " 2970
3414	794		Shale, blue,	soft		
<p>Last measurement 5/29/26 Steel line.</p>						
<p><u>PLUGGING RECORD</u></p> <p>May 30th, 1926.</p> <p>Bridged back to 2812 and waiting for shot. Well shot June 5th, with 100 qts. Nitro but did not hold at all that could be noticed. Well had about fifty feet of oil in it when shot was put in.</p> <p>June 8th, 1926.</p> <p>Pulled all 6 1/2" casing. Plugged back at 1500 feet. Put in 50 ft. of reek and dirt on top of bridge and dumped six sacks of cement on top of this.</p> <p>Pulled all 8 1/2" casing and 12 1/2" casing. Cellar to be filled and pipe marker left as soon as rig is moved.</p>						

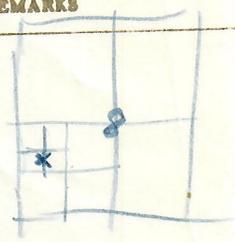

00197476

