



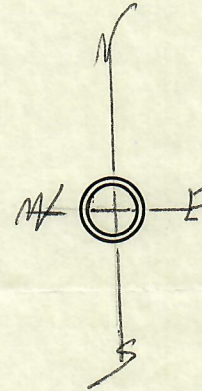

00208531

R-79-W

Frank de Lyndon
JACKSON COUNTY SURVEYOR
Coalmont, Colorado

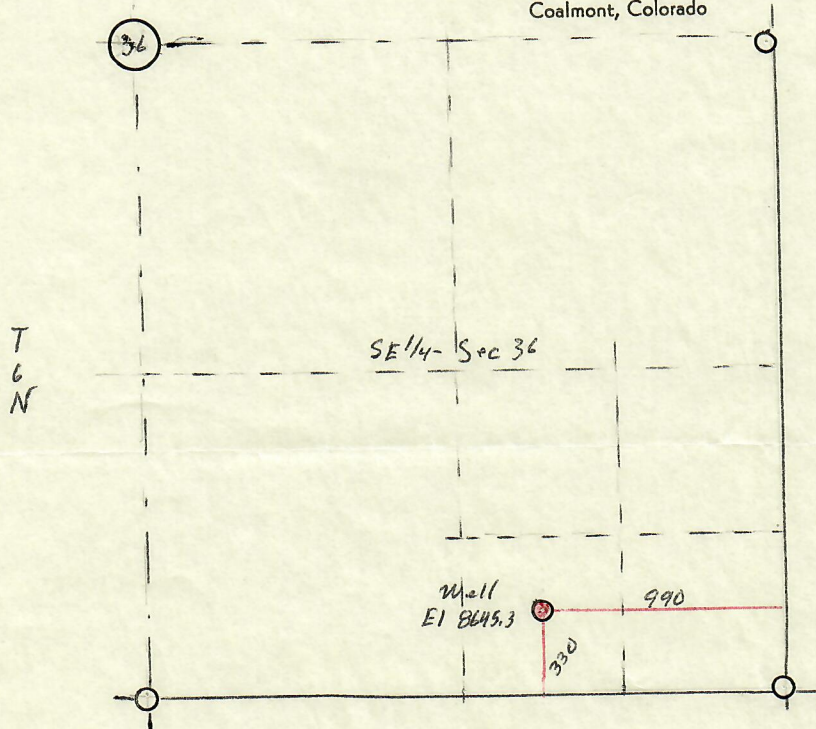

WELL LOCATION .. THE AMARADA PETROLIUM CO. .. COLORADO STATE .. "GOLD" #1
JACKSON COUNTY COLORADO

Location ... Center, SW 1/4 - SE 1/4 - SE 1/4, Section 36, Township 6 North,
Range 79 West of the 6th P.M. in Jackson County, Colorado.

From the East section line ... 990ft
" " South " " ... 330 ft

Elevation ... 8645.30 ft

Survey ... May 15 - 22 1963.

Field Notes Used .. U. S. Land Office Dependent Resurvey of 1938.

.....
F. de Lyndon Reg 377