



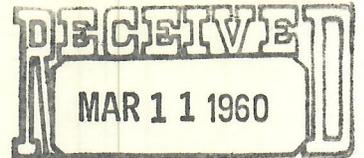

107-05225

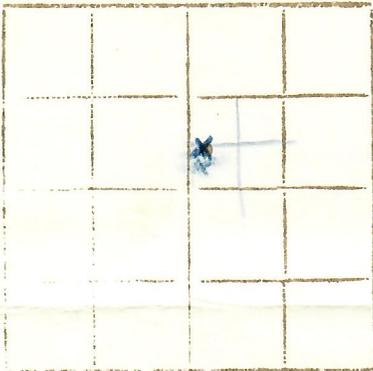

SEC. 19 TWP. 6N. R. 86W



TEXAS PRODUCTION COMPANY
and
CARTER OIL COMPANY.

OIL & GAS
CONSERVATION COMMISSION

SW NE 19-6N-86W

Bank #1, Tew Creek, Routt County,
Colorado.

674' N. of S. line and 220' E. of
W. line of SW $\frac{1}{4}$ NE $\frac{1}{4}$ Sec. 19, T. 6 N.,
R. 86 W. Elev. of ground 6967' above
sea level.

Commenced drilling: Sept. 27, 1925.
Completed drilling: March 4, 1926.
T.D. 4525 ft. - Water - Abandoned.

CASING RECORD:

15 $\frac{1}{2}$ "	70'	99'7"	Pulled after running 12 $\frac{1}{2}$ "
12 $\frac{1}{2}$ "	50'	1205'	Cemented.
10"	48'	2670'	Set at 2670'
8 $\frac{1}{2}$ "	36'	3966'11"	Cemented.
6 $\frac{1}{2}$ "	24'	4402'6"	



FORMATION RECORD:

Sandy clay, light, medium	0	30
Sandy shale, gray hard. Little water at 55' and 90'. Ran 102' 15 $\frac{1}{2}$ " casing.	30	110
Hole was crooked, casing pulled, hole filled with rock, redrilled and 99'7" of 15 $\frac{1}{2}$ " casing run.		
Shale, blue, hard	110	130
Sandy shale, blue, hard	130	155
Shale, brown, medium	155	335
Sandy shale, brown, medium	335	390
Shale, sandy, blue, hard	390	430
Sandy shale, blue, hard	430	440
Shale, blue, hard	440	450
Sandy shale, blue, hard	450	620
Sandy shale, blue, medium	620	655
Sandy shale, blue, hard	655	685
Shale, blue, soft	685	795
Sandy shale, blue, hard	795	850
Sandy shale, blue, soft	850	910
Sandy shale, blue, hard	910	970
Shale, brown, soft	970	1050
Sandy shale, blue, soft	1050	1130
Shale, brown, soft	1130	1185
Sandy shale, blue, hard Ran and cemented 1203' of 12 $\frac{1}{2}$ " casing and pulled 15 $\frac{1}{2}$ " casing	1185	1200
Shale, blue, medium	1200	1210
Sandy shale, blue, medium. Picked up 12 $\frac{1}{2}$ " to recement and parted casing. Fished it out and reran 1205' of 12 $\frac{1}{2}$ " and cemented		
Sandy shale, blue, hard	1210	1230
Shale, blue, hard	1230	1240
Shale, gray, soft	1240	1270
Sandy shale, blue, soft	1270	1320
Shale, blue, soft	1320	1400
Sandy shale, blue, soft	1400	1490
Shale, blue, soft	1490	1605
Sandy shale, blue, hard	1605	1720
Shale, blue, soft	1720	1800
Sandy shale, blue, soft	1800	1885
Shale, blue, soft	1885	1975
Sandy shale, blue, soft	1975	2065