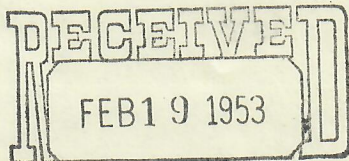


	30		

Locate
Well
Correct

00374845

File in _____ locate on Fee and Patented lands and in
quadruplicate on State and School lands, with
OFFICE OF DIRECTOR
OIL AND GAS CONSERVATION COMMISSION,
STATE OF COLORADOOIL & GAS
CONSERVATION COMMISSION

LOG OF OIL AND GAS WELL

Field Mt. Hope Company Shell Oil Company
County Logan Address Denham Bldg., Denver, Colorado
Lease C. F. Green 'A'
Well No. 5 Sec. 30 Twp. 9N Rge. 53W Meridian _____ State or Pat. _____
Location 330 Ft. ^(N)~~48~~ of South Line and 1650 Ft. ^(E)~~000~~ of West line of NW/4 Elevation 4203
(Derrick floor relative to sea level)

The information given herewith is a complete and correct record of the well and all work done thereon so far as can be determined from all available records.

Signed

W. H. InabnitDate 2-18-53

Title

Division Production Manager

The summary on this page is for the condition of the well as above date.

Commenced drilling 4-4-51, 19____ Finished drilling 4-27-51, 19____

OIL AND GAS SANDS OR ZONES

No. 1, from 863 to 4963 No. 4, from _____ to _____
No. 2, from _____ to _____ No. 5, from _____ to _____
No. 3, from _____ to _____ No. 6, from _____ to _____

IMPORTANT WATER SANDS

No. 1, from _____ to _____ No. 3, from _____ to _____
No. 2, from _____ to _____ No. 4, from _____ to _____

CASING RECORD

SIZE	WT. PER FOOT	MAKE	WHERE LANDED	NO. OF SKS. CEMENT	STOOD HOURS	PRESSURE TEST PSI
8 5/8"	32	-	352	175		
4 1/2"	9 1/2	Spang	5083	250		

COMPLETION DATA

Total Depth 4972 ft. Cable Tools from 5090 to 4972 Rotary Tools from 0 to 5090
Casing Perforations (prod. depth) from 4874 to 4890 ft. No. of holes _____
Acidized with _____ gallons. Other physical or chemical treatment of well to induce flow _____
Shooting Record _____

Prod. began 4-30 19 51 Making 352 bbls./day of 38.6 A. P. I. Gravity Fluid on 2" Pump ☐
Tub. Pres. _____ lbs./sq. in. Csg. Pres. _____ lbs./sq. in. Gas Vol. _____ Mcf. Gas Oil Ratio _____
Length Stroke _____ in. Strokes per Min. _____ Diam. Pump _____ in.
B. S. & W. _____ % Gas Gravity _____ BTU's/Mcf. _____ Gals. Gasoline/Mcf. _____

WELL DATA

Indicate (yes or no) whether or not the following information was obtained.

Electrical Log Yes Date 4-15 19 51 Straight Hole Survey _____ Type _____
Date _____ 19 _____
Other Types of Hole Survey Yes Type Microlog
Time Drilling Record Yes (Note—Any additional data can be shown on reverse side.)
Core Analysis No Depth _____ to _____
to _____

FORMATION RECORD

Show all formations, especially all sands and character and contents thereof.

FORMATION	TOP	BOTTOM	REMARKS
	0	3974	Shale
	3974	4045	Sand
	4045	4183	Shale
	4183	4356	Lime and shale.

(Continue on reverse side)

4356
4356-4410
4410
4410-4417
4417-4451
4451-4630
4630-4860
4860
4860-4897
4897-4960
4960
4960-5010
5010-5050
5050-5057
5057-5090
5090

Sample Top Timpas.
Line
Sample Top Codell.
Sand and Shale.
Shale.
Lime and shale
Shale.
Sample Top Muddy
Sand.
Shale.
Sample Top Dakota
Sand
Shale and sand.
Sand.
Sand and Shale.
V-TD


















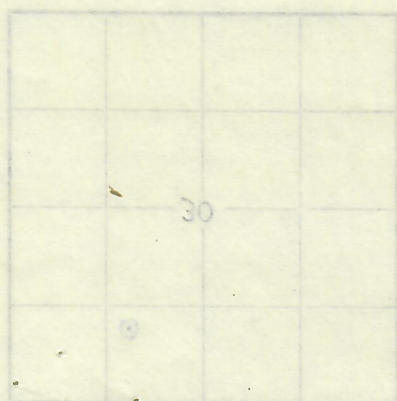

CONSERVATION COMMISSION
OIL & GAS

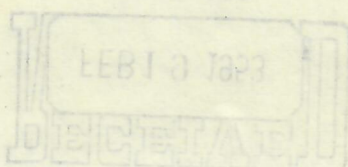

LOG OF OIL AND GAS WELL

