

WEYBURN 7-66-3-10-8C WELL LOCATION CERTIFICATE

N 1/4 COR. SEC. 34
3 1/2" ALUM. CAP
LS 20685, 1996

NW COR. SEC. 34
3 1/2" ALUM. CAP
PLS 10855, 1996
(FIELD DATE: 04-10-17)

N89°46'30"E 2672.12' (FIELD DATE: 04-10-17)

N89°46'19"E 1336.07'

N89°46'23"E 1336.10'

NE COR. SEC. 34
2 1/2" ALUM. CAP
9644, 1994
(FIELD DATE: 04-10-17)

SURFACE LOCATION:
GROUND ELEVATION=4993'
NAD83
LATITUDE:40.612670° N
LONGITUDE:104.757898° W

LANDING POINT LOCATION:
NAD83
LATITUDE:40.609945° N
LONGITUDE:104.756779° W

BOTTOM HOLE LOCATION:
NAD83
LATITUDE:40.583891° N
LONGITUDE:104.757149° W

NOTES:
BH LOCATION PROVIDED BY CLIENT.
LAND SURFACE USE-IMPROVED PASTURE
SEE LOCATION DRAWING FOR ADDITIONAL
IMPROVEMENTS WITHIN 500'

PDOP=2.3
GPS OPERATOR: MICHAEL HERNANDEZ

34

W 1/4 COR. SEC. 34
2 1/2" ALUM. CAP
LS 12374, 1996
(FIELD DATE: 04-10-17)

N89°28'30"E 2661.41'

N89°28'33"E 2639.88'

C 1/4 COR. SEC. 10
3 1/2" ALUM. CAP
PLS 38252, 2016
(FIELD DATE: 04-10-17)

E 1/4 COR. SEC. 34
2 1/2" ALUM. CAP
LS 12374, 1996
(FIELD DATE: 04-10-17)

N00°49'01"W 2638.83'

N00°35'08"W 2624.80'

S00°07'19"W 2611.12'

N00°42'30"W 2639.29'

N00°40'31"W 2638.63'

S00°09'25"E 2609.99'

**WEYBURN
7-66-3-10-8C**

W 1/4 COR. SEC. 34/3
2 1/2" ALUM. CAP
LS 12374, 199X
(FIELD DATE: 09-23-16)

S 1/4 COR. SEC. 34
3 1/2" ALUM. CAP
LS 7242, 1994
(FIELD DATE: 09-22-16)


SW COR. SEC. 34
2 1/2" ALUM. CAP
LS 12374, 1996
(FIELD DATE: 05-29-14)

S89°27'44"W 1330.00'

S89°27'35"W 1329.88'

S88°50'51"W 2616.36'
BASIS OF BEARINGS
(SEE NOTE 2)

LP: 528' FNL
788' FEL

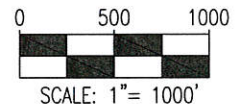

LEGEND

- = EXISTING MONUMENT
- = CALCULATED POSITION
- = PROPOSED WELL
- ◆ = EXISTING WELL
- ▲ = BOTTOM HOLE
- ▲ = LANDING POINT
- LP = LANDING POINT
- BHL = BOTTOM HOLE LOCATION

NOTES:


1. THIS FIELD SURVEY CONFORMS TO THE MINIMUM STANDARDS SET BY THE C.O.G.C.C., RULE NO. 215
2. BEARINGS ARE BASED ON THE ASSUMPTION THAT THE SOUTH LINE OF THE SOUTHEAST QUARTER OF SECTION 34, BEARS S88°50'51"W BETWEEN THE MONUMENTS SHOWN HEREON.
3. ALL DISTANCES AND BEARINGS SHOWN HEREON ARE GROUND VALUES AS GPS MEASURED IN THE FIELD, WITH TIES TO WELLS MEASURED PERPENDICULAR TO SECTION LINES. THIS LOW DISTORTION PROJECTION (LDP) IS BASED ON THE NORTH AMERICAN DATUM OF 1983, U.S. SURVEY FOOT WITH A LATITUDE ORIGIN OF 40.654718°N, A CENTRAL MERIDIAN LONGITUDE OF 104.772763°W, AND A SCALE FACTOR ON THE CENTRAL MERIDIAN OF 1.000241 (EXACT). THE LDP BASIS OF BEARINGS IS GEODETIC NORTH.
4. FIELD VERIFICATION OF MONUMENTS COMPLETED WITHIN 1 YEAR OF SIGNATURE DATE, UNLESS NOTED.

NOTICE: ACCORDING TO COLORADO LAW YOU MUST COMMENCE ANY LEGAL ACTION BASED UPON ANY DEFECT IN THIS SURVEY WITHIN THREE YEARS AFTER YOU FIRST DISCOVER SUCH DEFECT. IN NO EVENT MAY ANY ACTION BASED UPON ANY DEFECT IN THIS SURVEY BE COMMENCED MORE THAN TEN YEARS FROM THIS SAID DATE OF THIS CERTIFICATION SHOWN HEREON.

**WELL WEYBURN 7-66-3-10-8C TO BE
LOCATED 471' FSL & 1107' FEL**

I, MICHAEL L. POOL, A LICENSED PROFESSIONAL LAND SURVEYOR IN THE STATE OF COLORADO, DO HEREBY STATE THAT THIS WELL LOCATION CERTIFICATE WAS MADE FROM AN ACTUAL FIELD SURVEY PERFORMED UNDER MY RESPONSIBLE CHARGE ON THE DATE SHOWN HEREON AND CORRECTLY SHOWS THE LOCATION OF THE WELL SHOWN HEREON, AS STAKED ON THE GROUND, AND THE LOCATION OF THE LINES OF THE PUBLIC LAND SURVEY SYSTEM TO MY KNOWLEDGE, INFORMATION, AND BELIEF. THIS CERTIFICATE DOES NOT REPRESENT A LAND SURVEY PLAT OR IMPROVEMENT SURVEY PLAT AS DEFINED BY C.R.S. 38-51-102 AND IS IN ACCORDANCE WITH THE APPLICABLE STANDARDS OF PRACTICE FOR PROFESSIONAL LAND SURVEYING. THIS CERTIFICATE IS NOT A GUARANTEE OR WARRANTY, EITHER EXPRESSED OR IMPLIED.

MICHAEL L. POOL, PLS 38304
COLORADO LICENSED PROFESSIONAL LAND SURVEYOR
FOR AND ON BEHALF OF P.F.S., LLC
d.b.a. ASCENT GEOMATICS SOLUTIONS

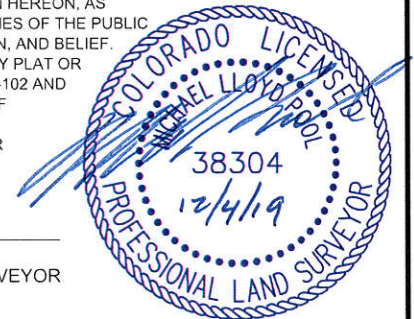

SHEET 1 OF 3




FIELD DATE:
04-28-17
DRAWING DATE:
12-03-19
BY:
IJM
CHECKED:
SJH

WELL NAME:
WEYBURN 7-66-3-10-8C
SURFACE LOCATION:
SE 1/4 SE 1/4 SEC. 34, T8N, R66W, 6TH P.M.
WELD COUNTY, COLORADO

PREPARED FOR:

enerPLUS

WEYBURN 7-66-3-10-8C WELL LOCATION CERTIFICATE

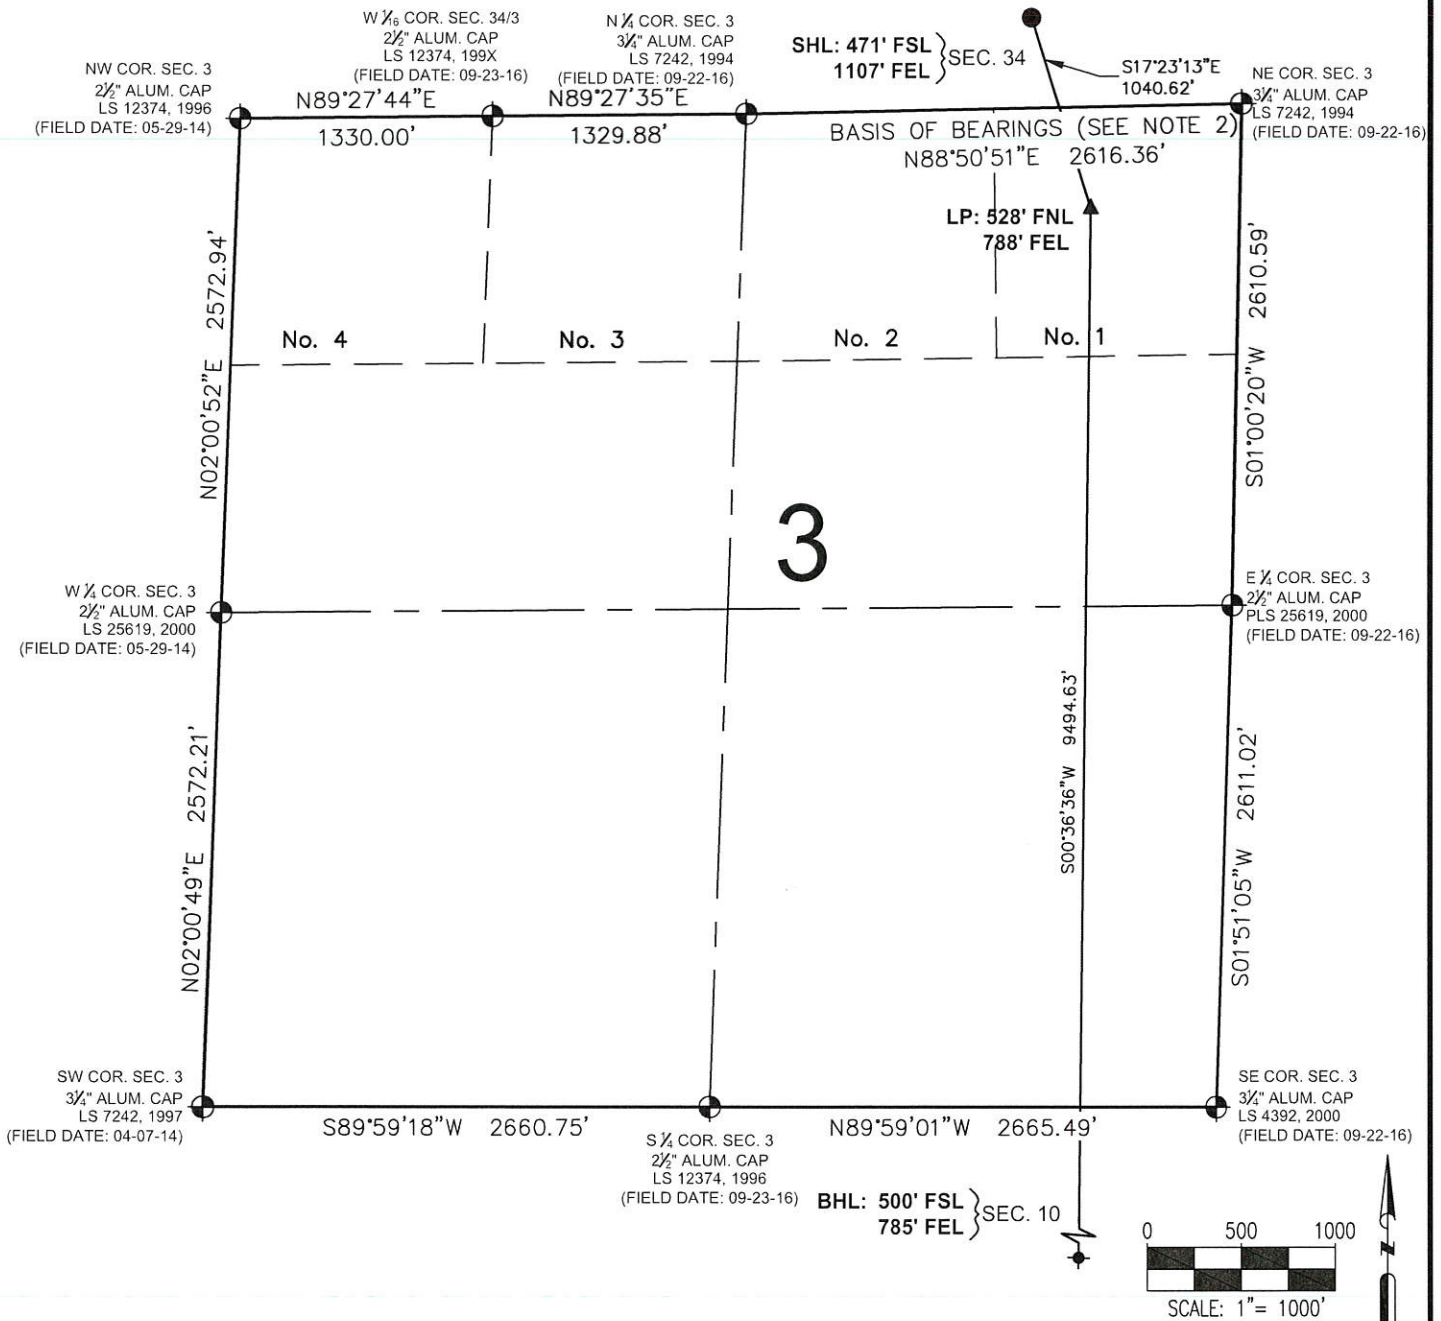

LEGEND

- = EXISTING MONUMENT
- = CALCULATED POSITION
- = PROPOSED WELL
- ◆ = EXISTING WELL
- ◆ = BOTTOM HOLE
- ▲ = LANDING POINT
- LP = LANDING POINT
- BHL = BOTTOM HOLE LOCATION

MICHAEL L. POOL, PLS 38304
COLORADO LICENSED PROFESSIONAL LAND SURVEYOR
FOR AND ON BEHALF OF P.F.S., LLC
d.b.a. ASCENT GEOMATICS SOLUTIONS



SHEET 2 OF 3



FIELD DATE:
04-28-17

DRAWING DATE:
12-03-19

BY:
IJM

CHECKED:
SJH



WELL NAME:
WEYBURN 7-66-3-10-8C

SURFACE LOCATION:
SE 1/4 SE 1/4 SEC. 34, T8N, R66W, 6TH P.M.
WELD COUNTY, COLORADO

PREPARED FOR:

enerPLUS


WEYBURN 7-66-3-10-8C WELL LOCATION CERTIFICATE

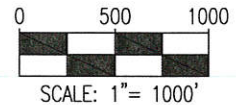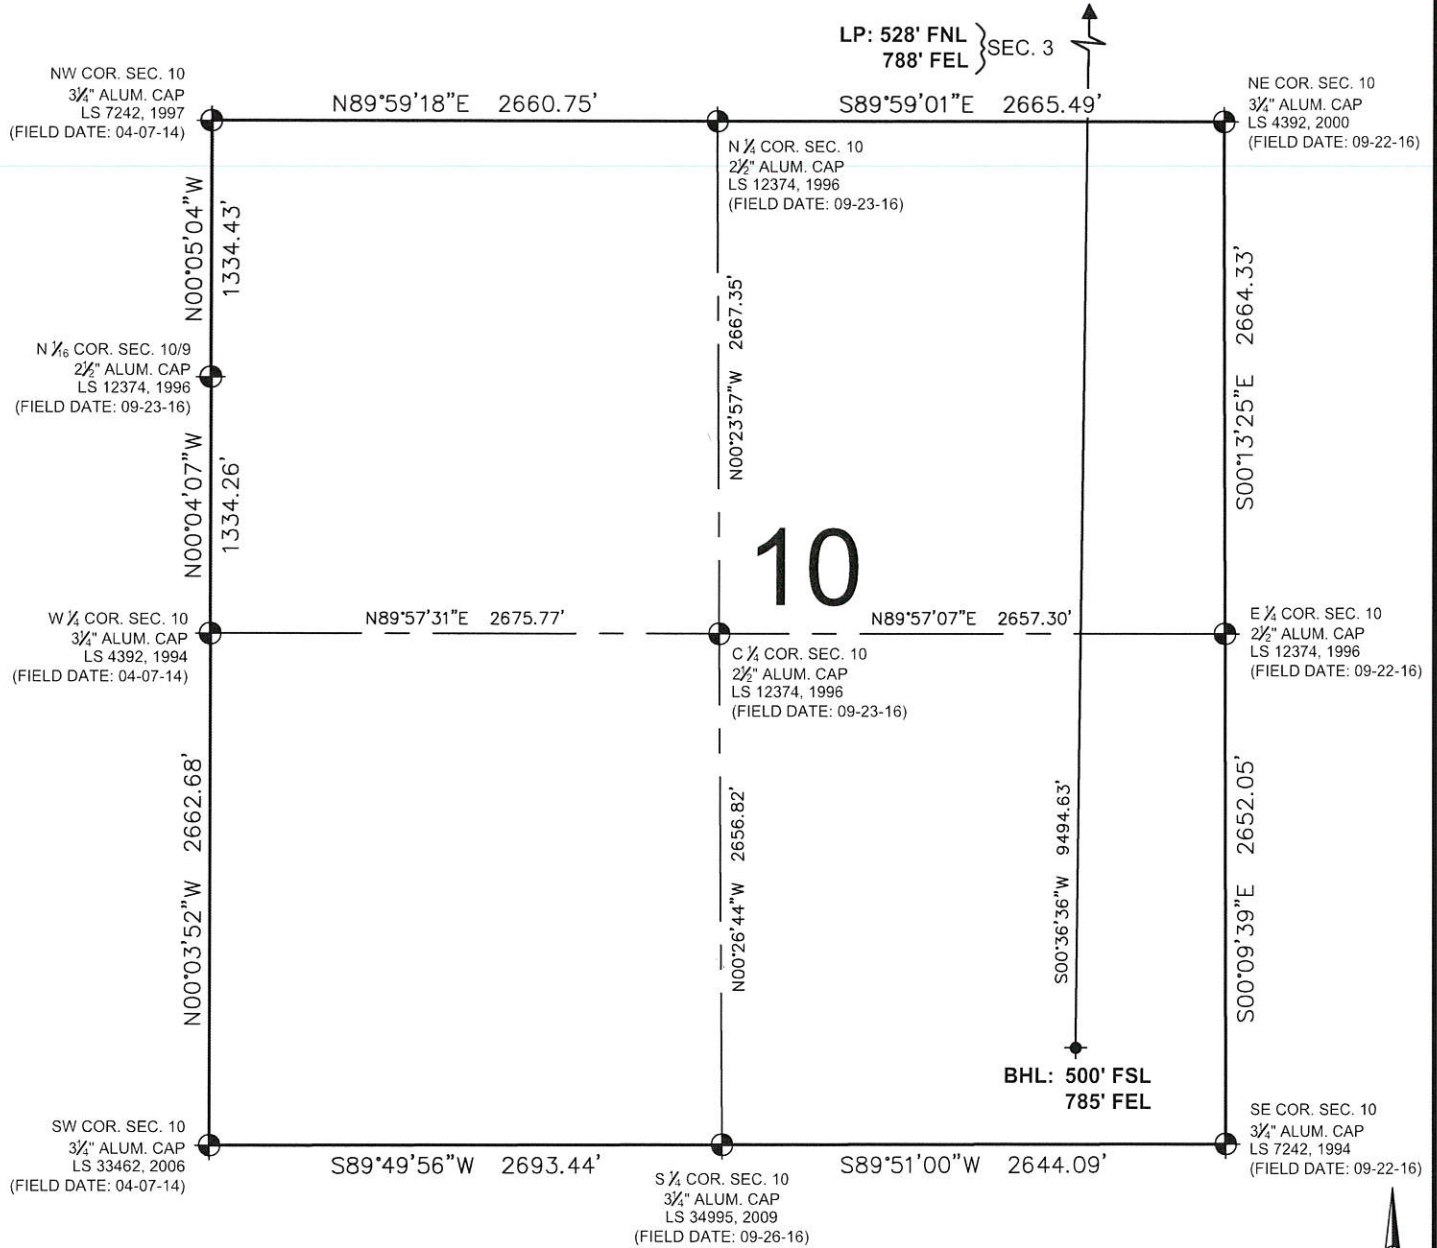

LEGEND

- = EXISTING MONUMENT
- = CALCULATED POSITION
- = PROPOSED WELL
- ◆ = EXISTING WELL
- ◆ = BOTTOM HOLE
- ▲ = LANDING POINT
- LP = LANDING POINT
- BHL = BOTTOM HOLE LOCATION

MICHAEL L. POOL, PLS 38304
COLORADO LICENSED PROFESSIONAL LAND SURVEYOR
FOR AND ON BEHALF OF P.F.S., LLC
d.b.a. ASCENT GEOMATICS SOLUTIONS

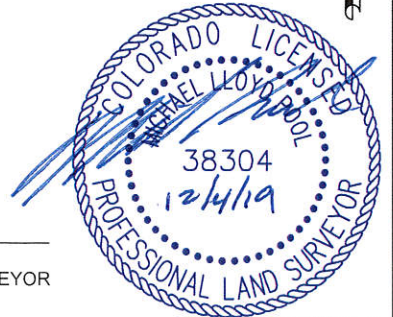

SHEET 3 OF 3



FIELD DATE:
04-28-17

DRAWING DATE:
12-03-19

BY
IJM

CHECKED:
SJH

WELL NAME:
WEYBURN 7-66-3-10-8C

SURFACE LOCATION:
SE 1/4 SE 1/4 SEC. 34, T8N, R66W, 6TH P.M.
WELD COUNTY, COLORADO

PREPARED FOR:

enerPLUS