




01309237

WELL LOCATION MAP

SECTION 30 TOWNSHIP 13 S RANGE 47 W

4

NORTH
1" = 1000'

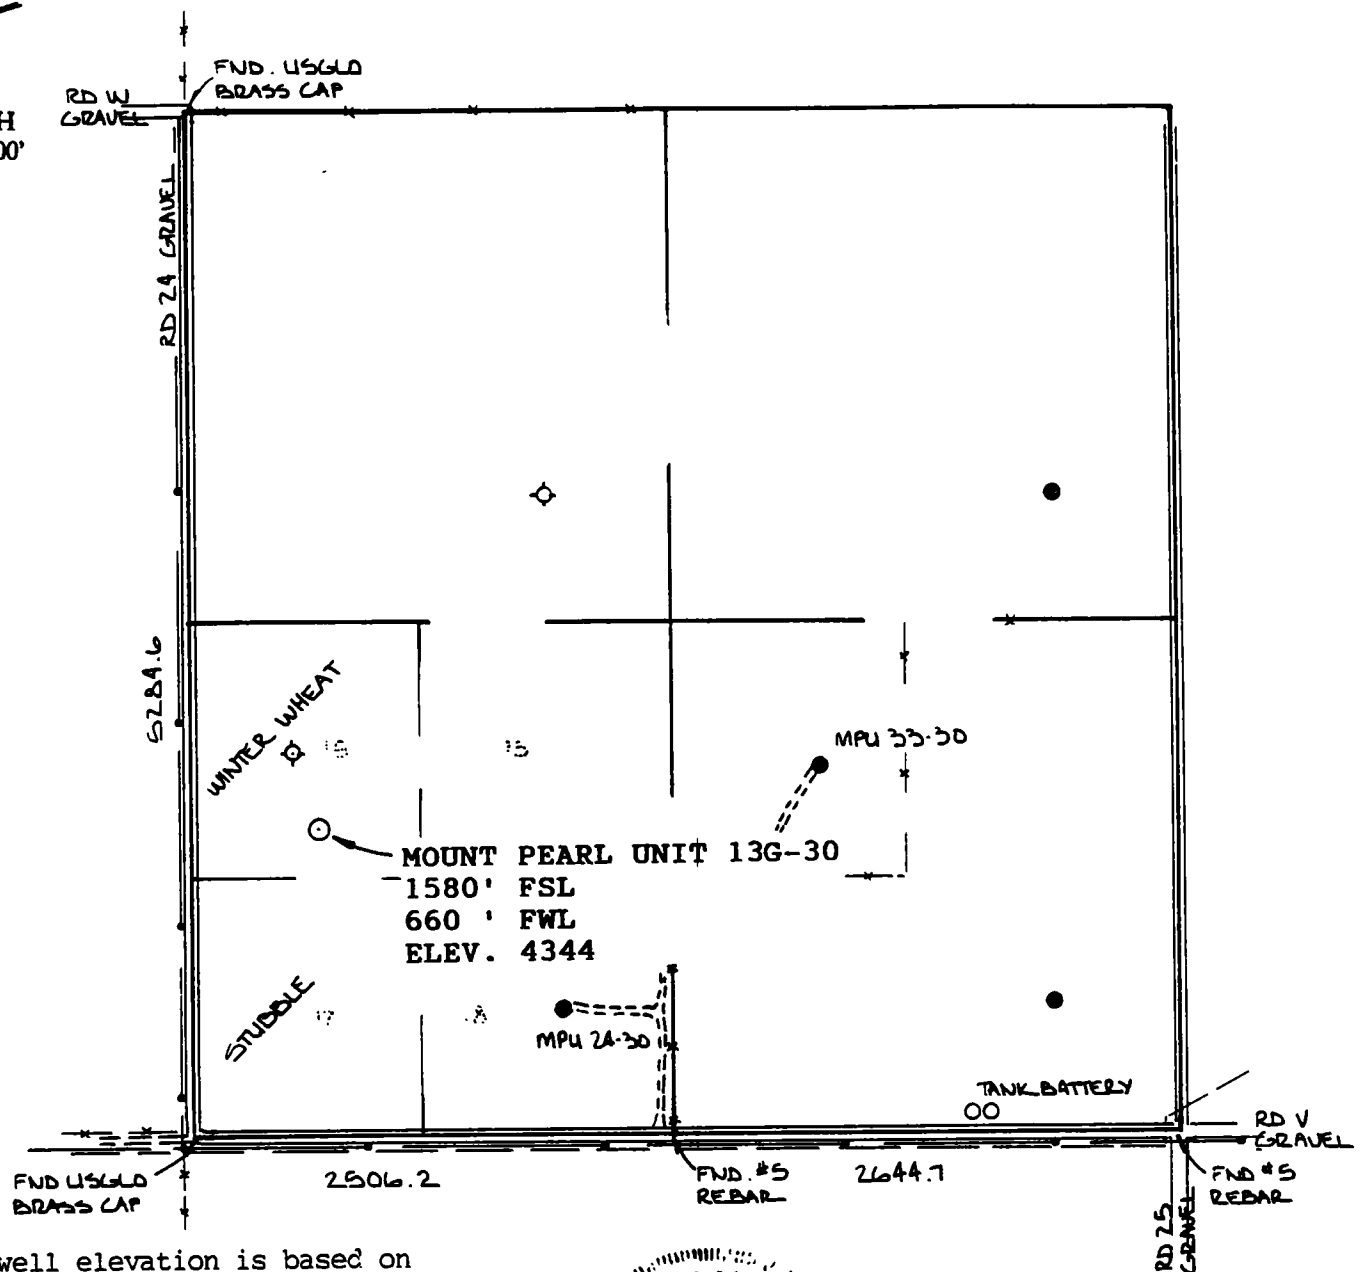

Note; well elevation is based on a spot elevation of 4361 at the NW corner of Section 30.



Legend:

- set well location
- +—+— fence line
- power line
- pipeline
- producing wells
- ◇ dry hole
- 16 lot 16 USGLO plat

Note: This is not a land survey or land survey plat.

Job # 5107-82

GEOSURV

E. J. Grabowski
PO Box 194
Lafayette, CO 80026
303-666-0379

Scale	1" = 1000'
Surveyed	EJG 9-90
Field Book	6
Calculated	EJG 9-90
Drawn	EJG 9-90

UNION PACIFIC RESOURCES

MOUNT PEARL UNIT 13G-30

SW 1/4
Section 30, T13S, R47W, 6 PM
Cheyenne County, Colorado