



FORM F-106



00250494


RECEIVED

JUN 2 01984

N

R. 52W

COLO. OIL & GAS CONS. COMM.

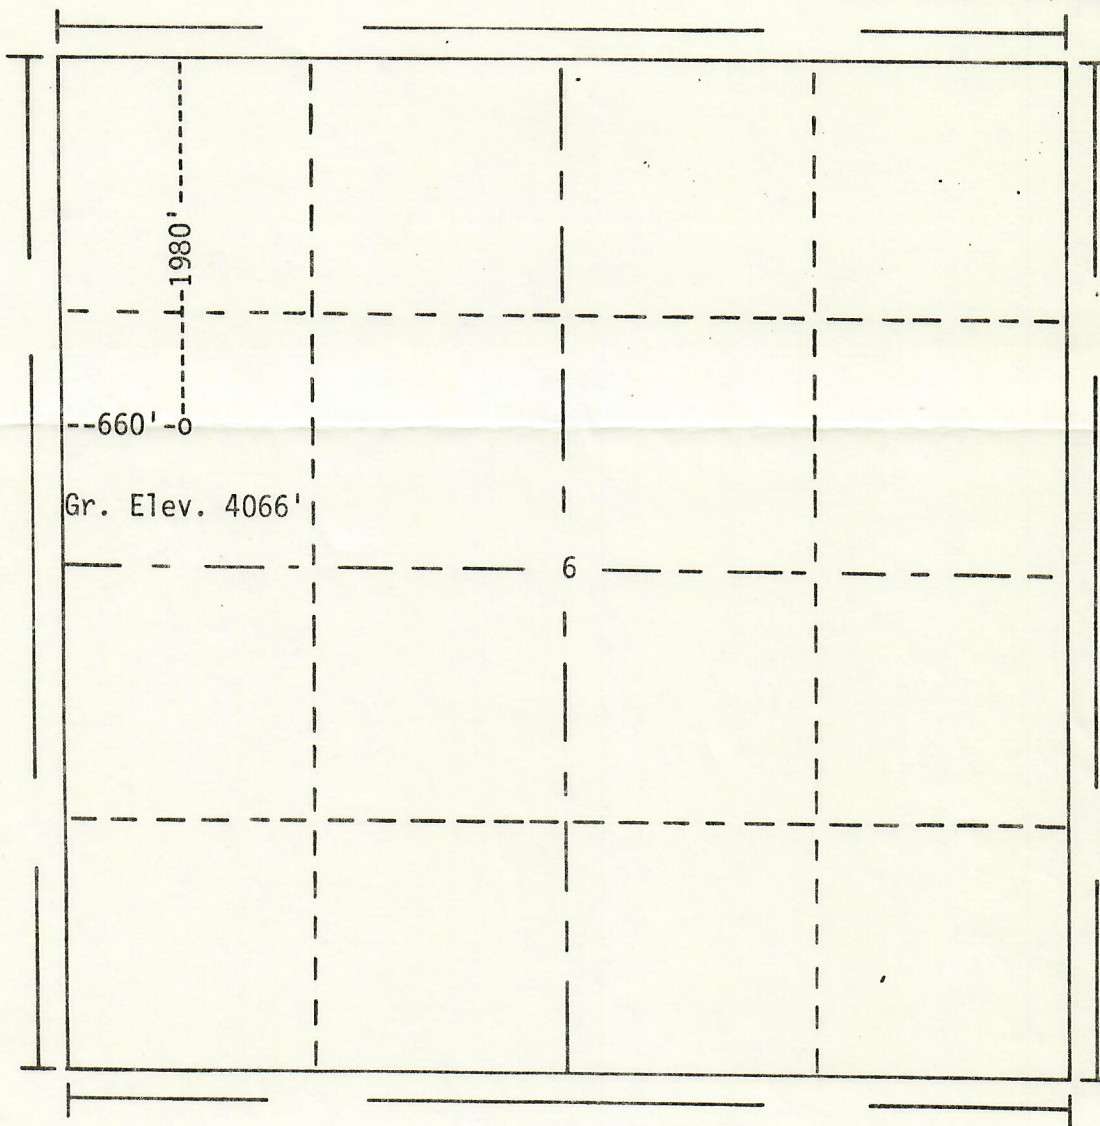


T. 9N

Scale... 1" = 1000'

Powers Elevation of Denver, Colorado
has in accordance with a request from Mr. Gear
for Oxoco Inc.
determined the location of No.6-1 Padroni
to be C-SW-NW Section 6 Township 9N
Range 52W of the 6th Principal Meridian
Logan County, Colorado

I hereby certify that this plat is an
accurate representation of a correct
survey showing the location of

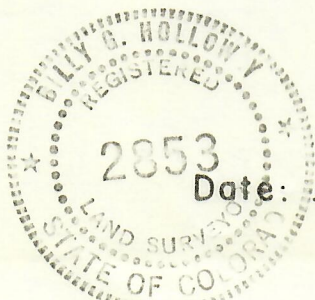

Date: 6-12-84

Billy G. Holloway

Licensed Land Surveyor No. 2853
State of Colorado