




State of Colorado  
Oil and Gas Conservation Commission  
DEPARTMENT OF NATURAL RESOURCES

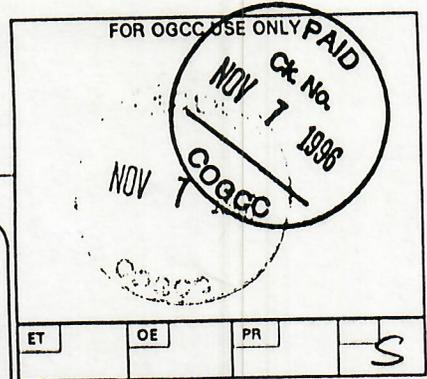

**Certification of Clearance and/or Change of Operator**

Send original plus as many copies as the number of wells plus five (5) additional copies. Use the back of this form for multiple wells changing from the same operator to the new operator or when the "Change of Transporter/Gatherer" on multiple wells are the same. This form is not to be used for Well Name changes or Status changes. A separate FORM 10 must be submitted for each new completion and a FORM 10 for each producing formation of a Multiple Completion. It is the Operator's responsibility to mail approved copies to the new Transporter and/or Gatherer for each well listed.

Operator Number: 27900	Contact Name & Phone BRENT MARCHANT
Name of Operator: EQUITY OIL COMPANY	No: (801) 521-3515
Address: TEN WEST 300 SOUTH (PO BOX 959)	Fax: (801) 521-3534
City: SALT LAKE CITY State: UT Zip: 84101	(84110)

**Operator Bond Status**

- Blanket  
 Individual

Page 1 of 2

Change of Operator

Change of Transporter or Gatherer

Effective Date: 9-15-96

Effective Date: \_\_\_\_\_

**Complete This Section For a New or Individual Well.**

OGCC Lease No:	API Number:
Well Name and Number:	Field Name and Number: WEST PADRONI (OK per Sharon Tansy)
Location (QtrQtr, Sec, Twp, Rng):	Acres in Lease:
Acres Assigned to Well <input type="checkbox"/> Standup <input type="checkbox"/> Laydown	Royalty Owner: <input type="checkbox"/> Fee <input type="checkbox"/> State <input type="checkbox"/> Federal <input type="checkbox"/> Indian
Method of Water Disposal Facility and/or Pit Number: _____	<input type="checkbox"/> Central Pit <input type="checkbox"/> Commercial Pit <input type="checkbox"/> On-site Pit <input type="checkbox"/> Injection Well <input type="checkbox"/> NA
Producing Formation(s) Recompletion? <input type="checkbox"/> Y <input type="checkbox"/> N	Current Well Status Date Shut In or Production Resumed
Multiple Well Lease? If yes, interests must be common. If existing OGCC Lease, Lease No.: _____ <input type="checkbox"/> Y <input type="checkbox"/> N	

OIL TRANSPORTER			GAS GATHERER		
Name	OGCC No.	Name	OGCC No.		
TEXACO TRADING & TRANSPORTATION, INC. 33940		Address			
Address PO BOX 5568 T.A.		City State Zip			
City	State	Zip			
DENVER	CO	80217-5568			
Area Code	Phone Number	Date of First Production This Formation	Area Code Phone Number Date of First Sales This Formation		
( 303 )	861-4475		( ) ( ) ( )		

**If Multiple Transporter or Gatherer, Complete the Following:**

OIL TRANSPORTER			GAS GATHERER		
Name	OGCC No.	Name	OGCC No.		
Address		Address			
City	State	Zip	City State Zip		
Area Code	Phone Number	Date of First Production This Formation	Area Code Phone Number Date of First Sales This Formation		
( )	( )		( ) ( ) ( )		

**Remarks:**

\_\_\_\_\_  
\_\_\_\_\_  
\_\_\_\_\_

The undersigned certifies that the rules and regulations of the Oil and Gas Conservation Commission of the State of Colorado have been complied with except as noted above and that the transporter(s) is (are) authorized to transport the oil and/or gas produced from the above described well and that this authorization will be valid until further notice to the transporter named herein or until cancelled by the Colorado Oil and Gas Conservation Commission.


Buyer or Current Operator's Signature <i>David M. Seery</i>	Seller's Signature <i>Chris M. Schulte</i>
Name of Company EQUITY OIL COMPANY	Name of Company BIRCH EXPLORATION, LLC
Title DAVID M. SEERY, ATTORNEY-IN-FACT	Title Manager
Date 9-15-96	Date 9-15-96

OGCC Approved: *B. Buehling* Title: **DIRECTOR** O & G Cons. Comm Date: **MAR 19 1997**


RECEIVED  
FEB 22 1983

COLA, OIL & GAS CONS. COMM.


— SOLID LINE - EXISTING LINES  
- - - DASHED LINES - PROPOSED LINES

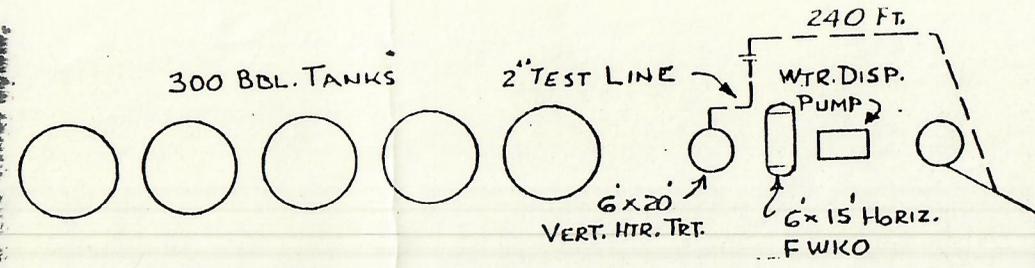

ARTHUR SINDT BATTERY

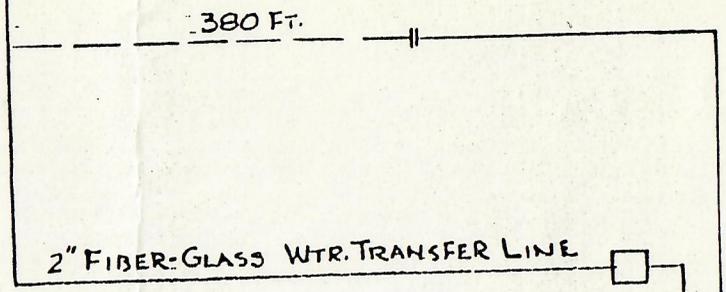

FRANCIS PARKE BATTERY

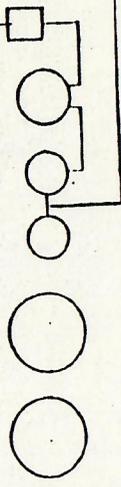

ARCO Oil and Gas Company

PROPOSE - CO-MINGLE F. PARKE PROD  
 WITH ARTHUR SINDT LEASE PROD.  
 AND TREAT & SELL OIL THROUGH  
 A. SINDT FACILITIES

Drawn  
D. LOGAN

DATE  
8/15/82