




- GPS Points
- Sample Locations

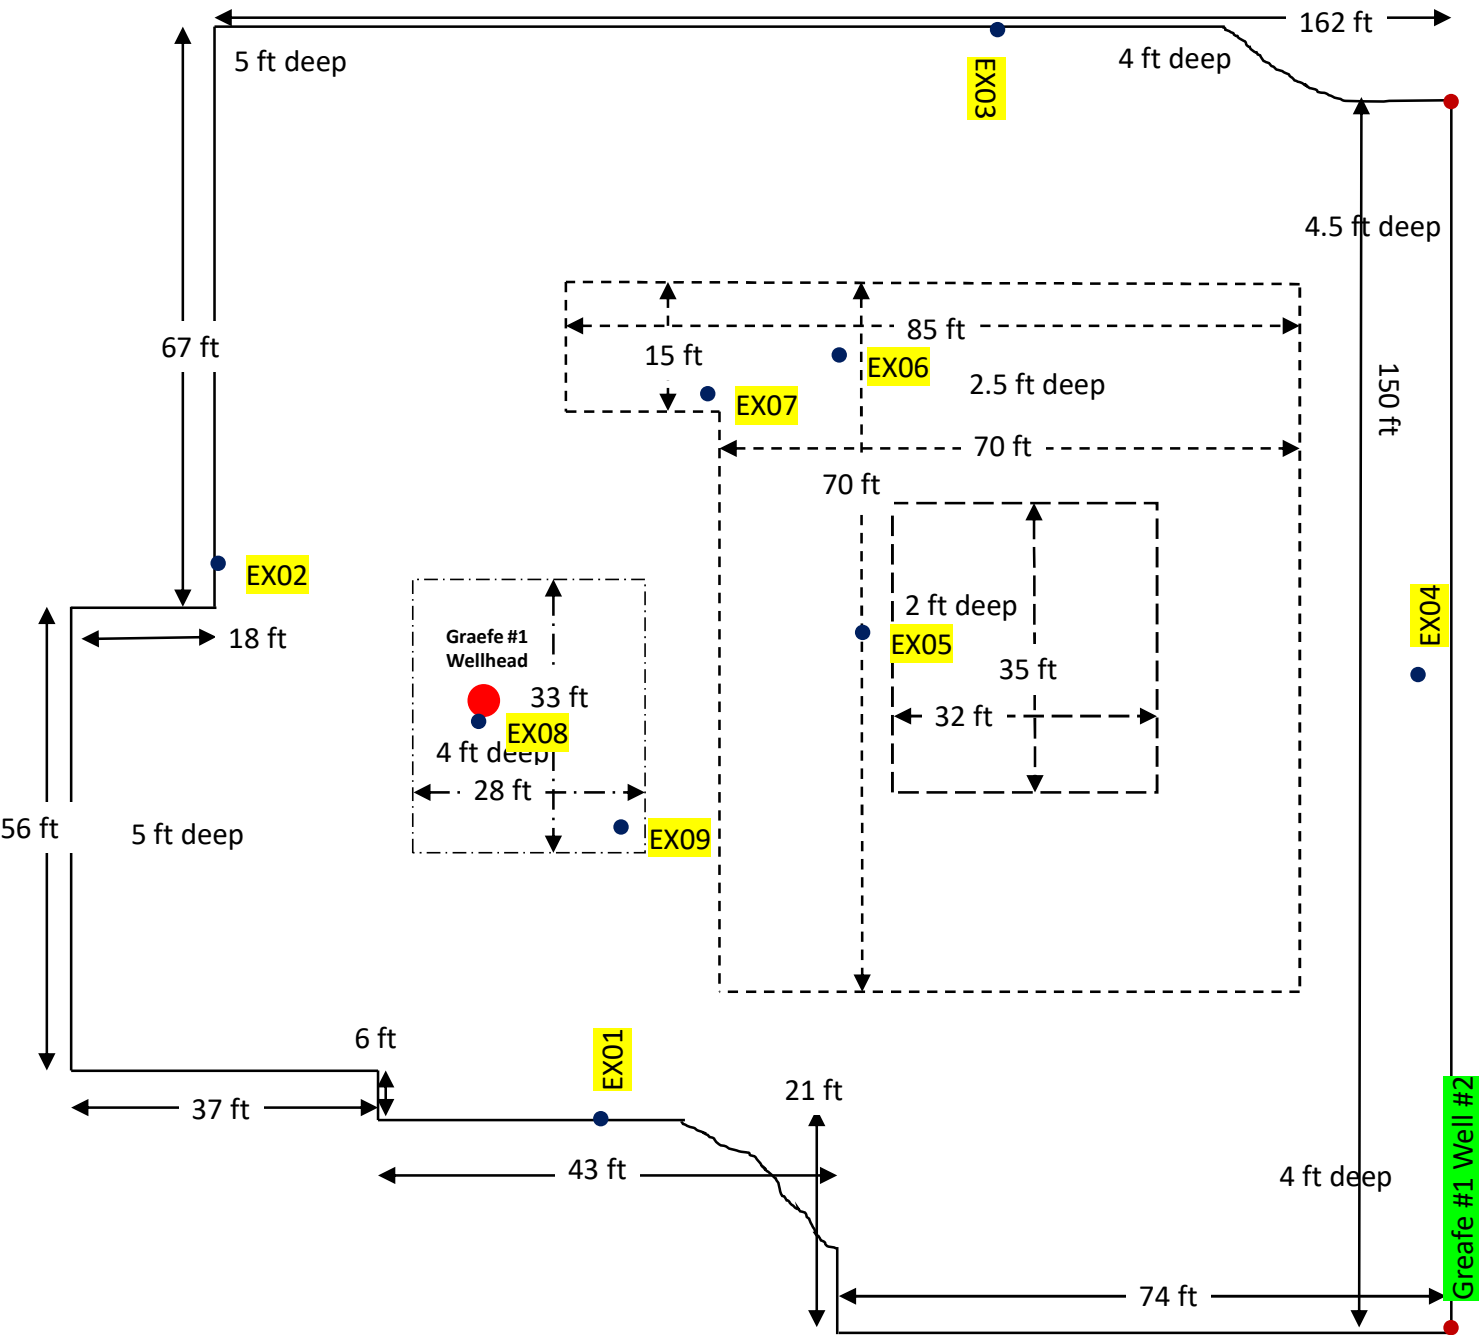

Graefe #1 - Well	
API: 05-123-06129	
SW NW Sec. 26 T9N-R62W PM6	
Weld County, Colorado	
Scale: 1 inch = 15 ft	Rev Date: September 6, 2019 Trent W. Green