


**Volume of pile**

4,060 ft<sup>3</sup>  
150.4 yd<sup>3</sup>

**Croissant #4 – Dirt Piles #2**

• **GPS Points**  
\*Composite Taken  
From Each Pile

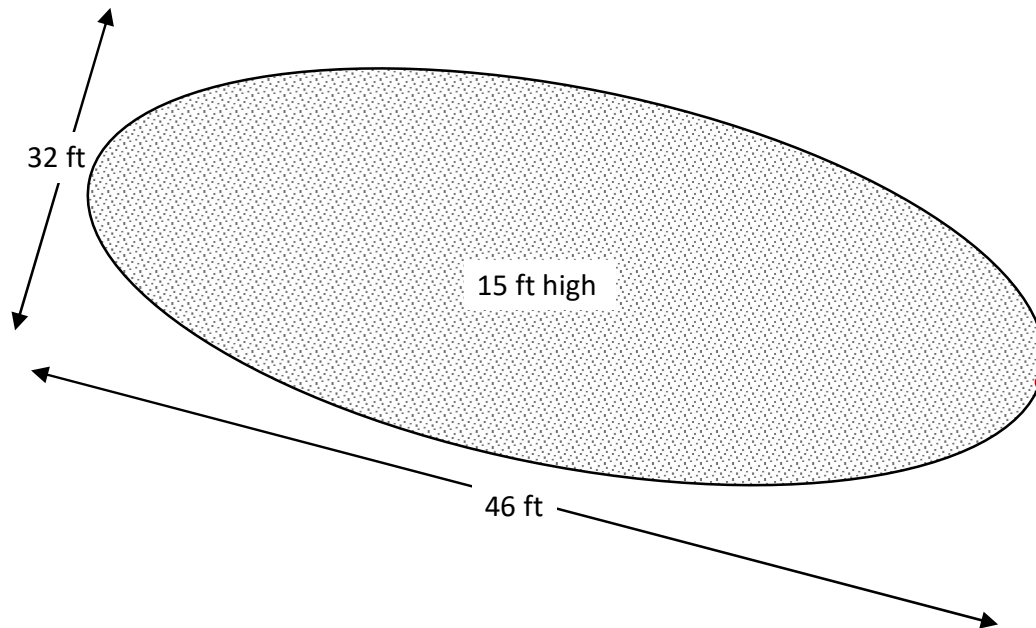

**Volume of pile**

22,080 ft<sup>3</sup>  
817.8 yd<sup>3</sup>

**Croissant #4 – Dirt Piles #1**

**Croissant #4 – Dirt Piles**

API: 05-123-21651

NW NW Sec. 26 T9N-R62W PM6

Weld County, Colorado

Rev Date: September 6, 2019  
Trent W. Green