

CERTIFICATE OF SURVEY
for
Mac Oil Co.,
Logan County, Colorado




00269958

RECEIVED
MAR - 2 1966

OIL & GAS
CONSERVATION COMMISSION

T9N R53W 6PM

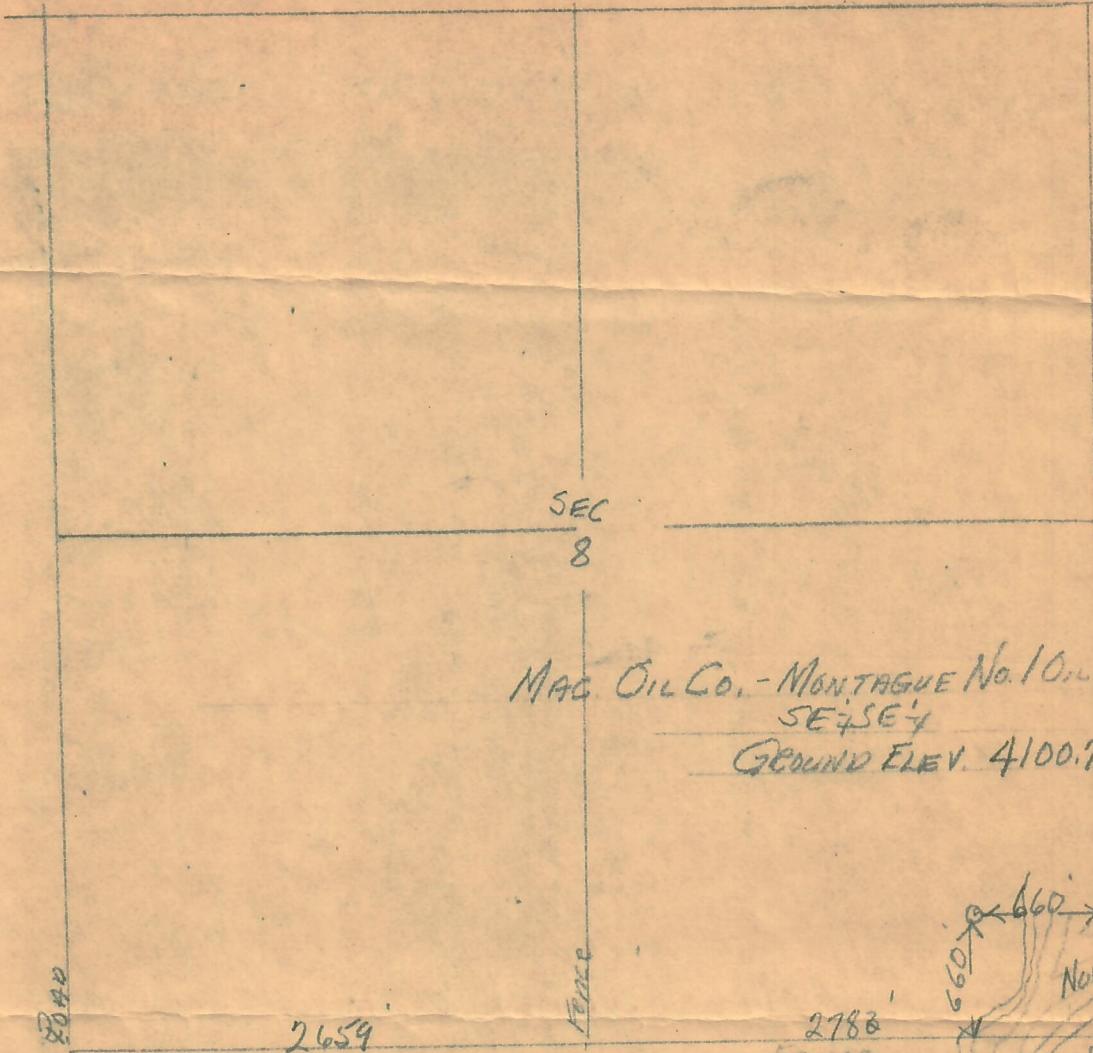

I hereby certify that the above plat is an accurate representation of a correct survey showing the location of Mac Oil Co. - Montague No. 1 Oilwell in SE₁/4 SE₁/4 Sec. 8 T9N R53W 6PM. The elevation of the ground at the stake is 4100.7 feet above sea level from U.S.G.S. Bench Mark.

Fort Morgan Colorado
Feb. 20, 1966

Lael J. Osborne
Registered Professional Engineer
State of Colorado

C