



FORM F-106

79-498


RECEIVED

JUN 18 1979

COLO. OIL & GAS CONS. COMM.



R. 53W

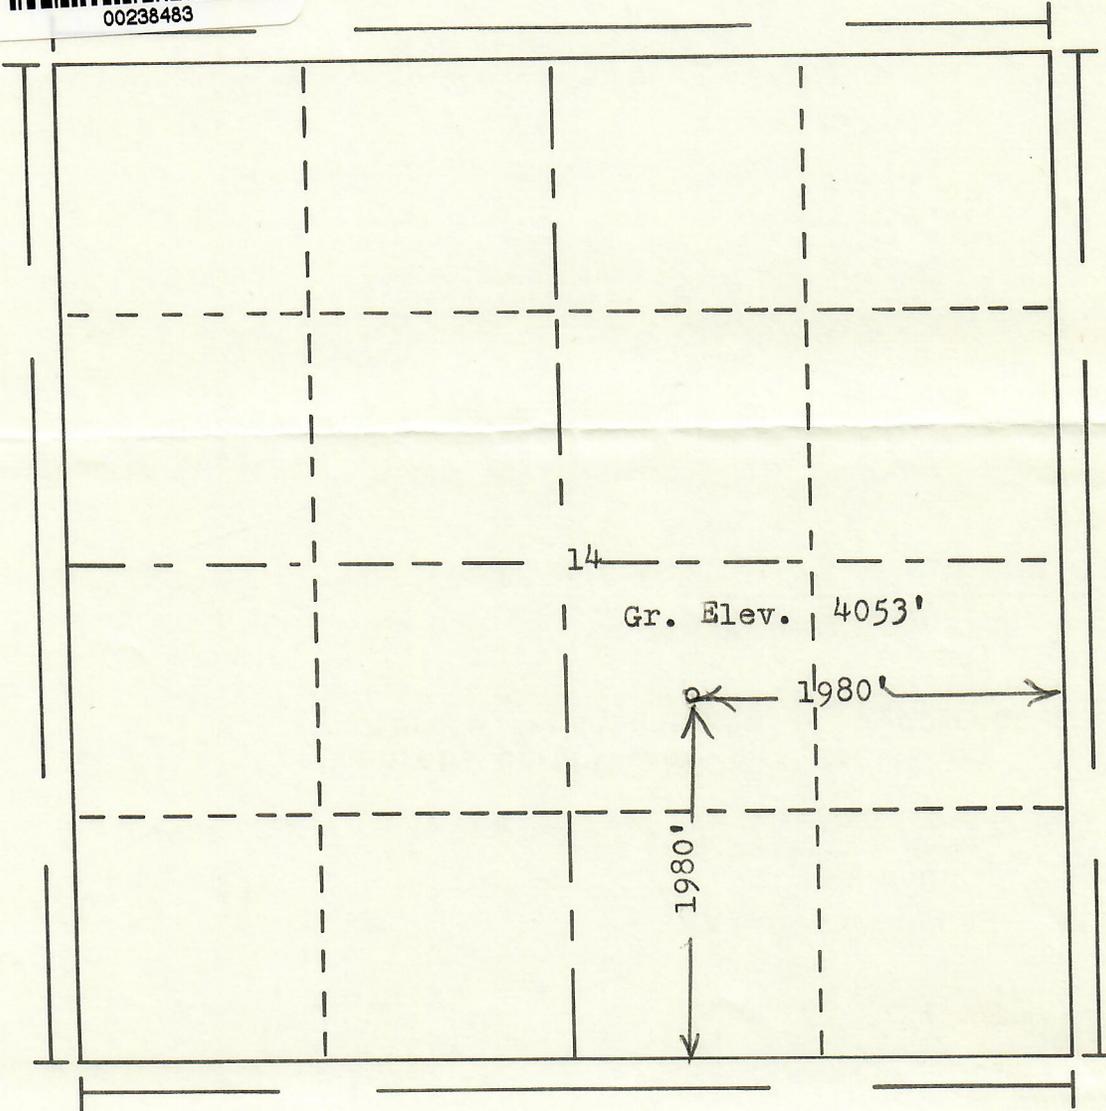

T. 9 N

Scale... 1" = 1000'

Powers Elevation Company, Inc. of Denver, Colorado has in accordance with a request from Mr. Arnum for Tipperary Corp. & Exeter Drlg. & Exploration Co. determined the location of No.1 Crosssant

to be CNW SE of the 6th Principal Section 14 Township 9N Range 53W Meridian Logan County, Colorado

I hereby certify that this plat is an accurate representation of a correct survey showing the location of

Date: 6-5-79

Licensed Land Surveyor No. 2853  
State of Colorado

