


Kaiser 8-3
Current WBD

1980 FNL660 FEL SENE 3 4N 64W 6th PM
Lat 40.34328 Long -104.52922
Weld County, Colorado
API #05-123-12523

Spud date 7/8/1985

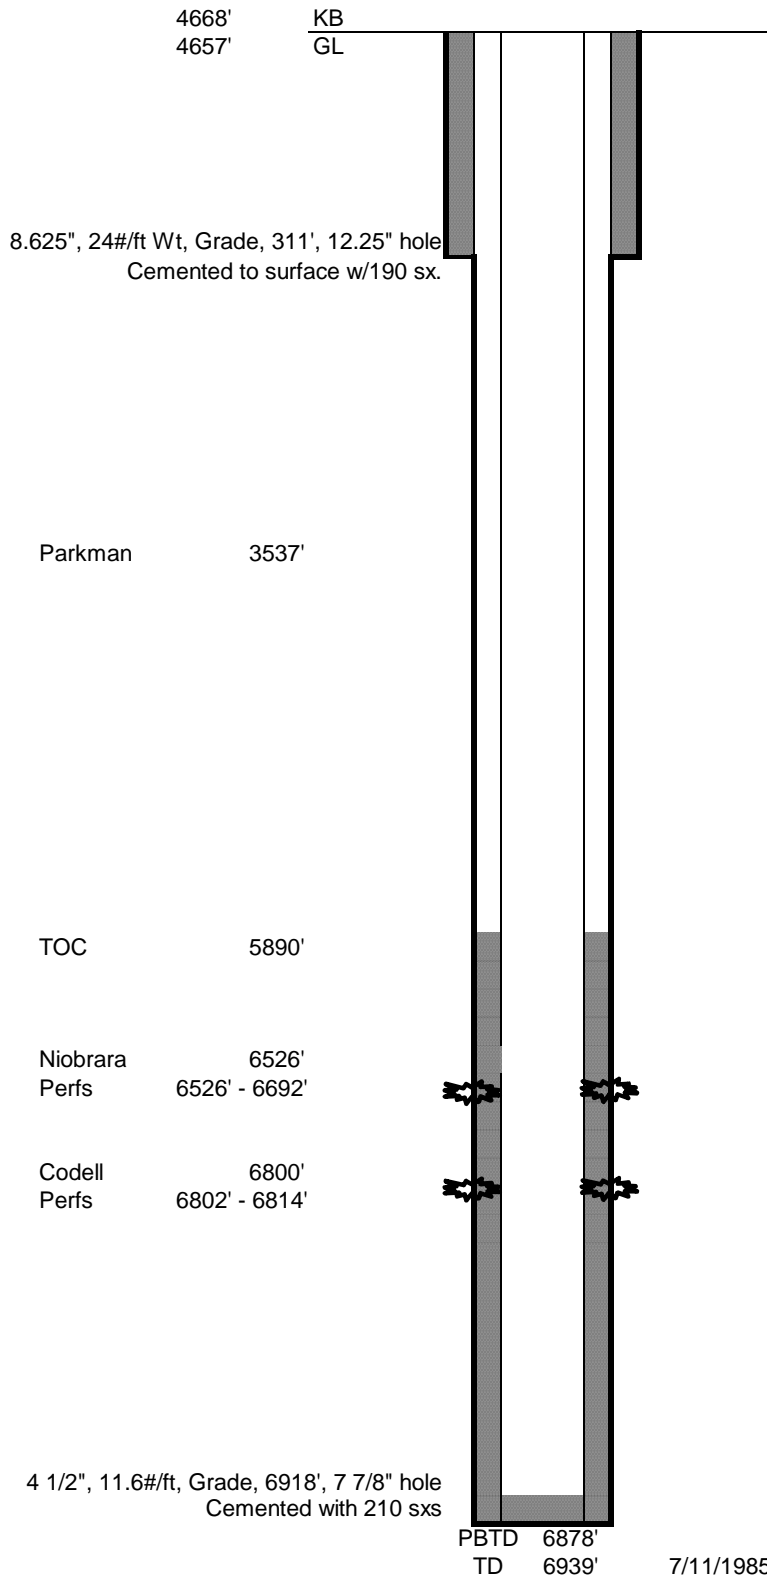

Updated 12/9/2019