

POLARIS 8-66-34-33C WELL LOCATION CERTIFICATE

N ¼ COR. SEC. 34
¾" ALUM. CAP
LS 20685, 1996

NW COR. SEC. 34
¾" ALUM. CAP
P.L.S. 10855, 1996
(FIELD DATE: 04-10-17)

N89°46'30"E 2672.12' (FIELD DATE: 04-10-17) N89°46'19"E 1336.07' E ¼ COR. SEC. 34/27
N89°46'23"E 1336.10'
2 ½" ALUM. CAP
PLS 16154, 1999
(FIELD DATE: 04-10-17)

NE COR. SEC. 34
2 ½" ALUM. CAP
9644, 1994
(FIELD DATE: 04-10-17)

SURFACE LOCATION:
GROUND ELEVATION=4993'
NAD83
LATITUDE:40.612574° N
LONGITUDE:104.757896° W

NOTES:
BH LOCATION PROVIDED BY CLIENT.
LAND SURFACE USE-IMPROVED PASTURE
SEE LOCATION DRAWING FOR ADDITIONAL
IMPROVEMENTS WITHIN 500'

LANDING POINT LOCATION:
NAD83
LATITUDE:40.616925° N
LONGITUDE:104.756168° W

PDOP=2.4
GPS OPERATOR: MICHAEL HERNANDEZ

BOTTOM HOLE LOCATION:
NAD83
LATITUDE:40.616625° N
LONGITUDE:104.789673° W

34

W ¼ COR. SEC. 34
2 ½" ALUM. CAP
LS 12374, 1996
(FIELD DATE: 04-10-17)

N89°28'30"E 2661.41'

N89°28'33"E 2639.88'

E ¼ COR. SEC. 34
2 ½" ALUM. CAP
LS 12374, 1996
(FIELD DATE: 04-10-17)

C ¼ COR. SEC. 10
¾" ALUM. CAP
PLS 38252, 2016
(FIELD DATE: 04-10-17)
S89°19'35"W 9304.77'

LP: 2012' FSL
623' FEL

BHL:
2012' FSL } SEC. 33
640' FWL }

N16°49'17"E
1656.74'

**POLARIS
8-66-34-33C**

S00°09'25"E 2609.99'

W ¼ COR. SEC. 34/3
2 ½" ALUM. CAP
LS 12374, 199X
(FIELD DATE: 09-23-16)

S ¼ COR. SEC. 34
¾" ALUM. CAP
LS 7242, 1994
(FIELD DATE: 09-22-16)

SE COR. SEC. 34
¾" ALUM. CAP
LS 7242, 1994
(FIELD DATE: 09-22-16)

SW COR. SEC. 34
2 ½" ALUM. CAP
LS 12374, 1996
(FIELD DATE: 05-29-14)

1330.00'
S89°27'44"W


1329.88'
S89°27'35"W

S88°50'51"W 2616.36'
(BASIS OF BEARINGS)

LEGEND

- = EXISTING MONUMENT ◆ = BOTTOM HOLE
- = CALCULATED POSITION ▲ = LANDING POINT
- = PROPOSED WELL LP = LANDING POINT
- ◆ = EXISTING WELL BHL = BOTTOM HOLE LOCATION

WELL POLARIS 8-66-34-33C TO BE LOCATED 436' FSL & 1107' FEL

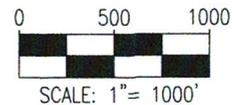

I, MICHAEL L. POOL, A LICENSED PROFESSIONAL LAND SURVEYOR IN THE STATE OF COLORADO, DO HEREBY STATE THAT THIS WELL LOCATION CERTIFICATE WAS MADE FROM AN ACTUAL FIELD SURVEY PERFORMED UNDER MY RESPONSIBLE CHARGE ON THE DATE SHOWN HEREON AND CORRECTLY SHOWS THE LOCATION OF THE WELL SHOWN HEREON, AS STAKED ON THE GROUND, AND THE LOCATION OF THE LINES OF THE PUBLIC LAND SURVEY SYSTEM TO MY KNOWLEDGE, INFORMATION, AND BELIEF. THIS CERTIFICATE DOES NOT REPRESENT A LAND SURVEY PLAT OR IMPROVEMENT SURVEY PLAT AS DEFINED BY C.R.S. 38-51-102 AND IS IN ACCORDANCE WITH THE APPLICABLE STANDARDS OF PRACTICE FOR PROFESSIONAL LAND SURVEYING. THIS CERTIFICATE IS NOT A GUARANTY OR WARRANTY, EITHER EXPRESSED OR IMPLIED.



MICHAEL L. POOL, PLS 38304
COLORADO LICENSED PROFESSIONAL LAND SURVEYOR
FOR AND ON BEHALF OF P.F.S., LLC
d.b.a. ASCENT GEOMATICS SOLUTIONS



- NOTES:**
- THIS FIELD SURVEY CONFORMS TO THE MINIMUM STANDARDS SET BY THE C.O.G.C.C., RULE NO. 215
 - BEARINGS ARE BASED ON THE ASSUMPTION THAT THE SOUTH LINE OF THE SOUTHEAST QUARTER OF SECTION 34, BEARS S88°50'51"W BETWEEN THE MONUMENTS SHOWN HEREON.
 - ALL DISTANCES AND BEARINGS SHOWN HEREON ARE GROUND VALUES AS GPS MEASURED IN THE FIELD, WITH TIES TO WELLS MEASURED PERPENDICULAR TO SECTION LINES. THIS LOW DISTORTION PROJECTION (LDP) IS BASED ON THE NORTH AMERICAN DATUM OF 1983, U.S. SURVEY FOOT WITH A LATITUDE ORIGIN OF 40.654718°N, A CENTRAL MERIDIAN LONGITUDE OF 104.727263°W, AND A SCALE FACTOR ON THE CENTRAL MERIDIAN OF 1.000241 (EXACT). THE LDP BASIS OF BEARINGS IS GEODETIC NORTH.
 - FIELD VERIFICATION OF MONUMENTS COMPLETED WITHIN 1 YEAR OF SIGNATURE DATE, UNLESS NOTED.

NOTICE: ACCORDING TO COLORADO LAW YOU MUST COMMENCE ANY LEGAL ACTION BASED UPON ANY DEFECT IN THIS SURVEY WITHIN THREE YEARS AFTER YOU FIRST DISCOVER SUCH DEFECT. IN NO EVENT MAY ANY ACTION BASED UPON ANY DEFECT IN THIS SURVEY BE COMMENCED MORE THAN TEN YEARS FROM THIS SAID DATE OF THIS CERTIFICATION SHOWN HEREON.

SHEET 1 OF 2

 8620 Wolff Court Westminster, CO 80031 (303) 928-7128 www.ascentgeomatics.com	FIELD DATE: 04-28-17	WELL NAME: POLARIS 8-66-34-33C	PREPARED FOR:
	DRAWING DATE: 12-09-19	SURFACE LOCATION: SE 1/4 SE 1/4 SEC. 34, T8N, R66W, 6TH P.M.	
BY: IJM	CHECKED: SJH	WELD COUNTY, COLORADO	

POLARIS 8-66-34-33C WELL LOCATION CERTIFICATE

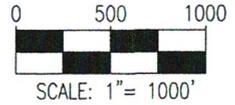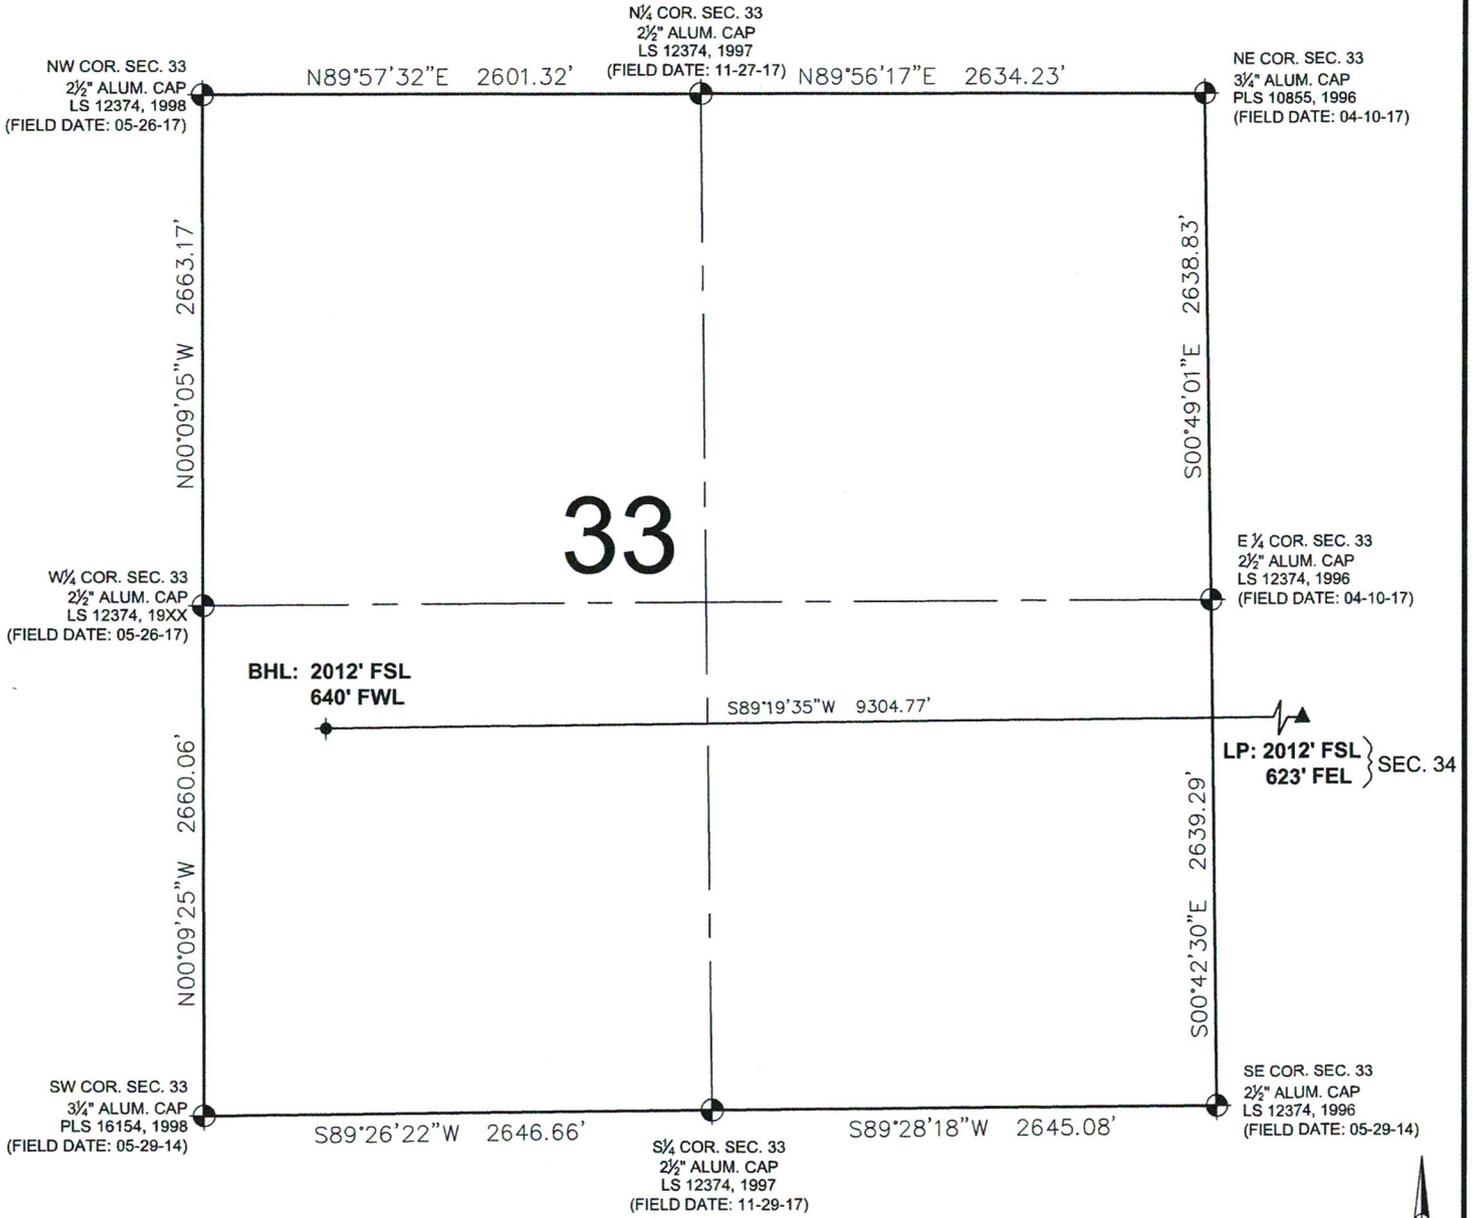

LEGEND

- ⊙ = EXISTING MONUMENT ◆ = BOTTOM HOLE
- = CALCULATED POSITION ▲ = LANDING POINT
- = PROPOSED WELL LP = LANDING POINT
- ◆ = EXISTING WELL BHL = BOTTOM HOLE LOCATION

MICHAEL L. POOL, PLS 38304
 COLORADO LICENSED PROFESSIONAL LAND SURVEYOR
 FOR AND ON BEHALF OF P.F.S., LLC
 d.b.a. ASCENT GEOMATICS SOLUTIONS

SHEET 2 OF 2

8620 Wolff Court
 Westminster, CO 80031
 (303) 928-7128
 www.ascentgeomatics.com

FIELD DATE: 04-28-17	DRAWING DATE: 12-09-19
BY: IJM	CHECKED: SJH

WELL NAME: POLARIS 8-66-34-33C
SURFACE LOCATION: SE 1/4 SE 1/4 SEC. 34, T8N, R66W, 6TH P.M. WELD COUNTY, COLORADO

PREPARED FOR: