

CERTIFICATE OF SURVEY
for
Kimbark Exploration Co.
Logan County, Colorado




MAR 16 1966

OIL & GAS
CONSERVATION COMMISSION

T9N R52W 6PM

5376' Q Road

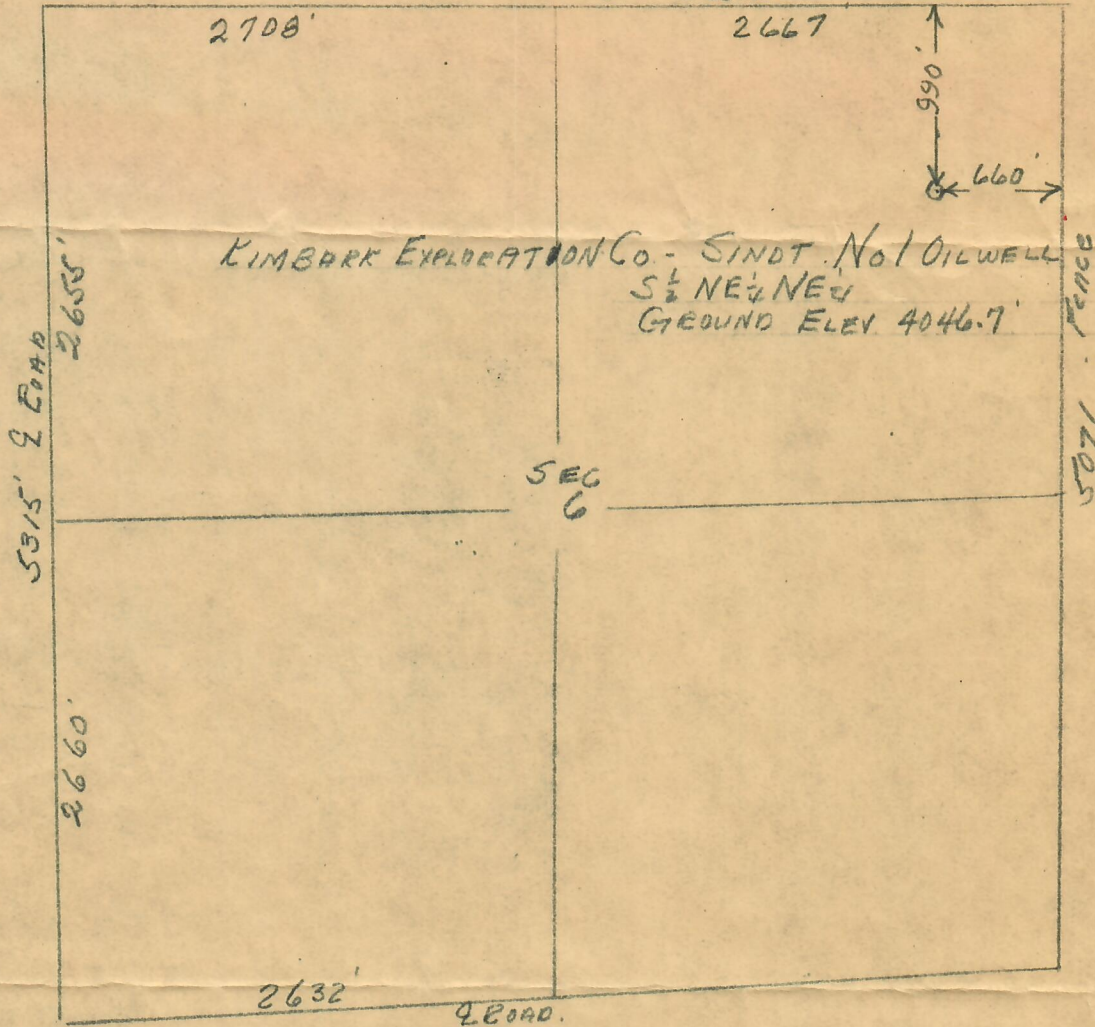

I hereby certify that the above plat is an accurate representation of a correct survey showing the location of Kimbark Exploration Co. - Sindt No. 1 Oilwell in S 1/2 NE 1/4 NE 1/4 Sec. 6 T9N R52W 6PM. The elevation of the ground at the stake is 4046.7 feet above sea level from U.S.C.S. Bench Mark.

Fort Morgan, Colorado
March 10, 1966

Laurel J. Osborne
Registered Professional Engineer
State of Colorado

6-9N-52W.
1 Sindt

66 74