


NWNNWNW 17-6N-86W

TEXAS PRODUCTION COMPANY

Henry Dennis #5

TOW CREEK, ROUTT COUNTY, COLORADO

Location 220' S. of N.line  
and 220' E. of W. line of  
Sec. 17, T. 6 N., R. 86 W.

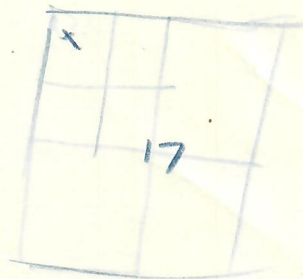

Spudded Oct. 18, 1928  
Completed Dec. 5, 1928.

CASING RECORD:

15 1/2" @  
387' 5" 12 1/2" @ 390' Cem. 10 sacks  
1292' 9" 10" @ 1299' not cemented  
8 1/2" @ 2606' cem. 15 sacks

0	6	Soil, sandy - spudding
6	38	Gravel - Hole full water
38	41	Shale, blue
41	80	Shale, gray. Drove 4 jts. 15 1/2" - Water shut off
80	140	Shale, gray. Hitched on beam at 100'
140	150	Shale, dark. Show oil, gas and water at 140'
150	400	Shale, gray (1 1/2' bailer water at 265' (Cemented 12 1/2" at 390' with 10 sacks cement)
400	580	Shale, brown
580	650	Shale, gray
650	1200	Shale, dark. Run 56 jts. 10" amt. 1194' 3"
1200	1285	Shale, gray U/R 10" to 1263'
1285	1455	Shale, gray U/R 10" to 1298'
1455	1460	Shale, blue 6 bailers water per hour
1460	2170	Shale, dark Water exhausted
2170	2185	Shale, black 6 bailers water. Show oil & gas at 2170'
2185	2555	Shale, gray More gas at 2425 and 2555' (1 Million)
2550	2600	Shale, gray Ran 106 jts. (2606') 8 1/2" cem. 15 sacks (Pulled all 10" after cementing 8 1/2")
2600	2675	Shale, gray Show oil at 2615'
2675	2685	Shale, gray, soft 100" oil in hole - little gas
2685	2740	Shale, dark
2740	2750	Shale, gray More oil - 200 ft. in hole
2750	2825	Shale, dark 300' oil in hole
2825	2885	Shale, dark 400' oil in hole
2885	2955	Shale, dark 450' oil in hole
2955	2980	Shale, dark 500' oil in hole (more oil)
2980	3020	Shale, dark 500' oil in hole
3020	3105	Shale, gray 600' oil in hole (Hole washed clean and put on pump)