

Foundation Energy Management, LLC

WELLBORE DIAGRAM

Well / Battery	Prospect Name		Total Depth	Current Status
Sooner	SOONER		6,450'	SI
Location	Sec-Twn-Rng		Producing Horizon	County & State
21-6-15	21-8N-58W		D-SAND	WELD, CO

WELLBORE DIAGRAM

Prepared Date:

Prepared By: mike jumper

General Info

API #: 05-123-19226

KB Elevation: 4,727'

GL Elevation:

Spud Date: 11/27/1996

Completion Date: 12/29/1996

TVD:

MD: 6,450'

Last PBTD:

Tubing Detail

2-3/8" inch(OD)

4.6 # (weight)

6,219' depth

Surface Casing

8-5/8" inch (OD)
24 # (weight)
J-55 grade
204' depth from KB
SURF cement top
125 sacks of cement
12-1/4" inch (OD) HOLE SIZE

Production Casing

4-1/2" inch (OD)
11.6 # (weight)
STC grade
6,450' depth from KB
4,800' cement top
265 sacks of cement
7-7/8" inch (OD) HOLE SIZE


Open Perforations

6,302'-6,320' (72 holes)

Pump Details:
none

Pumping Unit Details:

Well Notes:

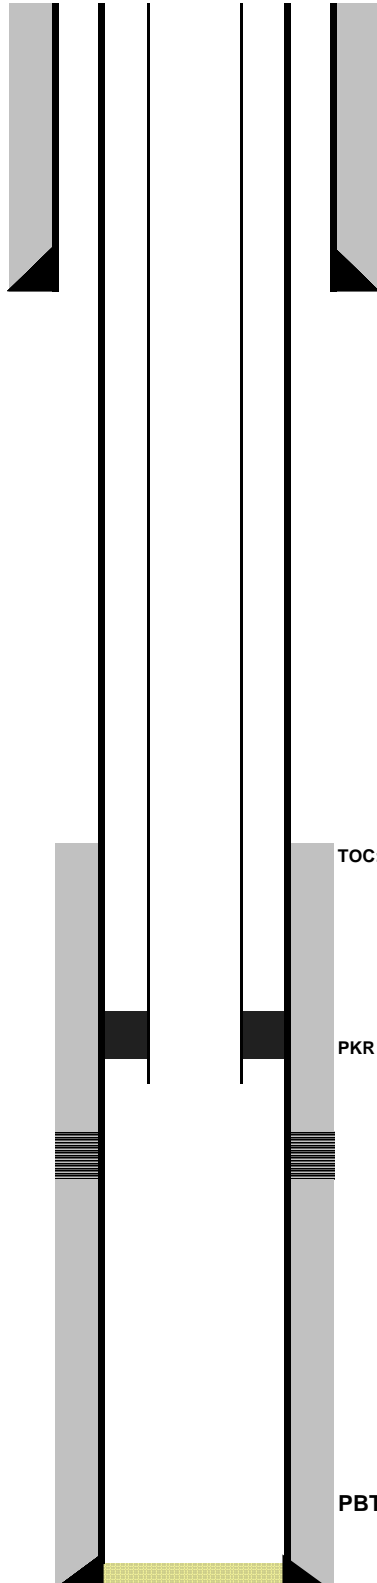

TOC: 4,800'

PKR @ 6,219'

PBTD: