


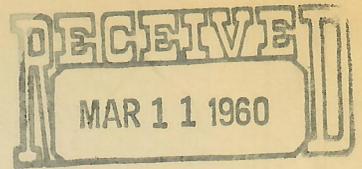

99999999

107-05214



OIL & GAS  
CONSERVATION COMMISSION


NE SE SW 5-6N-86W

TEXAS PRODUCTION COMPANY

John McNeil Well #1

TOW CREEK FIELD, ROUTT COUNTY, COLORADO.

Loc'n: 300' S. of N. line and 270' W. of  
E. line SE $\frac{1}{4}$  SW $\frac{1}{4}$  Sec. 5, T.6 N., R.86 W.

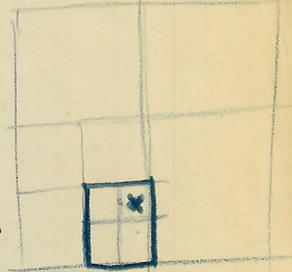

Surface Elevation 6644' (Ground)

Commenced drilling March 24, 1927  
Completed drilling July 10, 1927.

Total Depth 3000', Hole lost.

Formation	Bottom	Amount	Color	Hard or Soft	Remarks
Gravel	7	7	Yellow	Med.	Water in gravel
Sand	15	8	"	"	Water in sand
Shale	70	55	Blue	"	20" set at 15' 15 $\frac{1}{2}$ " " " 186'
Shale - sandy	1330	1260	"	"	12 $\frac{1}{2}$ " " " 1500'
"	1420	90	"	Hard	Bad hole at 875' " " " 1450'
"	3000	1580	"	Med.	" " Filled up to 875' with rock. Drilled out

10" casing run to  
2920'. Casing parted  
and dropped 2400' of  
casing.

After 10" was pulled  
12 $\frac{1}{2}$ " Collapsed at 875'  
10" would not pass  
back down, 8 $\frac{1}{4}$ " was  
tried but would not  
pass.

Hole filled with mud from bottom up to 235',  
cemented with 35 sack cement and gravel up  
to 215', mudded to top. Cellar will be  
leveled and marker set as soon as location  
is cleared.



00587643



TEXAS PRODUCTION COMPANY

John McNeil #2

TOW CREEK, ROUTT COUNTY,  
COLORADO.

CASING RECORD:


20"	90'	41'
15 1/2"	70	75'
12 1/2"	50	1235'
10"		2709'
8 1/2"		3082'

Location: 220' S. of N. line  
& 220' E. of W. line of NE 1/4  
SW 1/4 Sec. 5, T. 6 N., R. 86 W.

cemented Elevation Derrick floor 6818'

Commenced drilling Aug. 7, 1927.  
Completed drilling

0	20	Surface soil
20	70	Sand, yellow, soft. Ran 41' 6" of 20" casing.
70	165	Shale, blue. Ran 15 1/2" to 75' shut off sand
165	75	Filled hole with rock to 75' and redrilled.
165	185	Shale, blue
185	1025	Sandy shale, blue, med.
1025	1075	Shale, dark, soft
1075	1235	Sandy shale, blue, med. Cemented 12 1/2" at 1235'
1235	1920	Sandy shale, blue, med. Bad hole, filled back to 1840' and redrilled.
1920	2725	Sandy shale, blue, med. 10" set at 2709'
2725	2750	Sandy shale, gray, med.
2750	2815	Shale, dark, med.
2815	2865	Sandy shale, blue, med.
2865	3027	Sandy shale, blue, hard. Show gas at 2929'
3027	3410	Sandy shale, blue, hard Lowered 8 1/2" to 3082' and shut down.

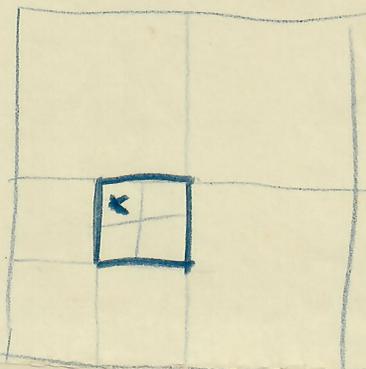

56  
6818  
- 2929  
3689