

OIL AND GAS CONSERVATION COMMISSION  
OF THE STATE OF COLORADO

OCT 1 - 1958

OIL & GAS  
CONSERVATION COMMISSION

## NOTICE OF INTENTION TO DRILL

## INSTRUCTIONS:

A notice of intention to drill a well shall be filed in duplicate on all Federal and Patented lands, and in triplicate on all State lands. Do not begin operations until approved copy has been received. It is mandatory that the proposed location comply with all rules and regulations of the Commission. Locate well on section grid in proper location, and indicate extent of lease. Unless operations are commenced within 180 days after the date of approval hereof, this approval to drill will become null and void.

Name of Operator CABEEN EXPLORATION CORPORATION Phone No. AM 6-1635  
Address 945 Petroleum Club Bldg. City Denver 2, State Colorado


How is liability secured: Well Bond (Attached) ☐; Blanket Bond ☒; Waiver ☐  
(Check one)

Lease Name Starick

Well No. 1-A

Field Name Hidden Valley Wildcat ☒

County Routt

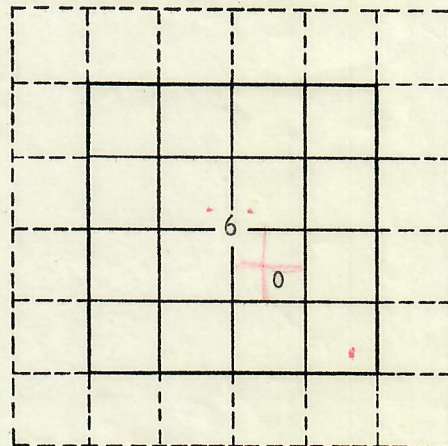

Location C SE NW SE (quarter quarter) Section 6 Township 6N Range 86W Meridian 6th  
1650 feet from S Section line and 1650 feet from E Section Line  
N or S E or W

The well is located on: Patented land ☒ State land ☐ Federal land ☐

The well is located within a spaced area: Yes ☒ No ☐

Distance from proposed location to nearest property or lease line 990 feet.

Distance from proposed location to nearest drilling unit line 1040 feet.

Objectives: Niobrara Depth 3200 ; Formation Estimate Formation Depth Estimate

Proposed length of surface casing 100 feet.

## REMARKS:

Will drill with cable tools to test the Niobrara fractured shale zone at approximately 3200'. Will set 5-1/2" casing on top of pay and drill into pay section. Caving and water bearing formations will be controlled with intermediate casing strings.

Agent	<u>OK</u>
Bond	<u>waived</u>
Spot	<u>Shale</u>
600 ft.	<u>822</u>
1200 ft.	
Wells	
Oil	
Gas	
Status	

107-05106



00544871

I/We hereby swear (or affirm) that the statements herein made are a full and correct report.

## APPROVED:

Date OCT - 1 1958

A. J. Gersin  
Director

Company CABEEN EXPLORATION CORP. Date 9/30/58

Address 945 Petroleum Club Bldg. Phone No. AM 6 1/2-1635

By P. J. Westrup Signature Title Petroleum Engr.

P. J. Westrup