



FORM F-106




RECEIVED

NOV 24 1972

R. 82 W.

COLD OIL & GAS CO., CORP.

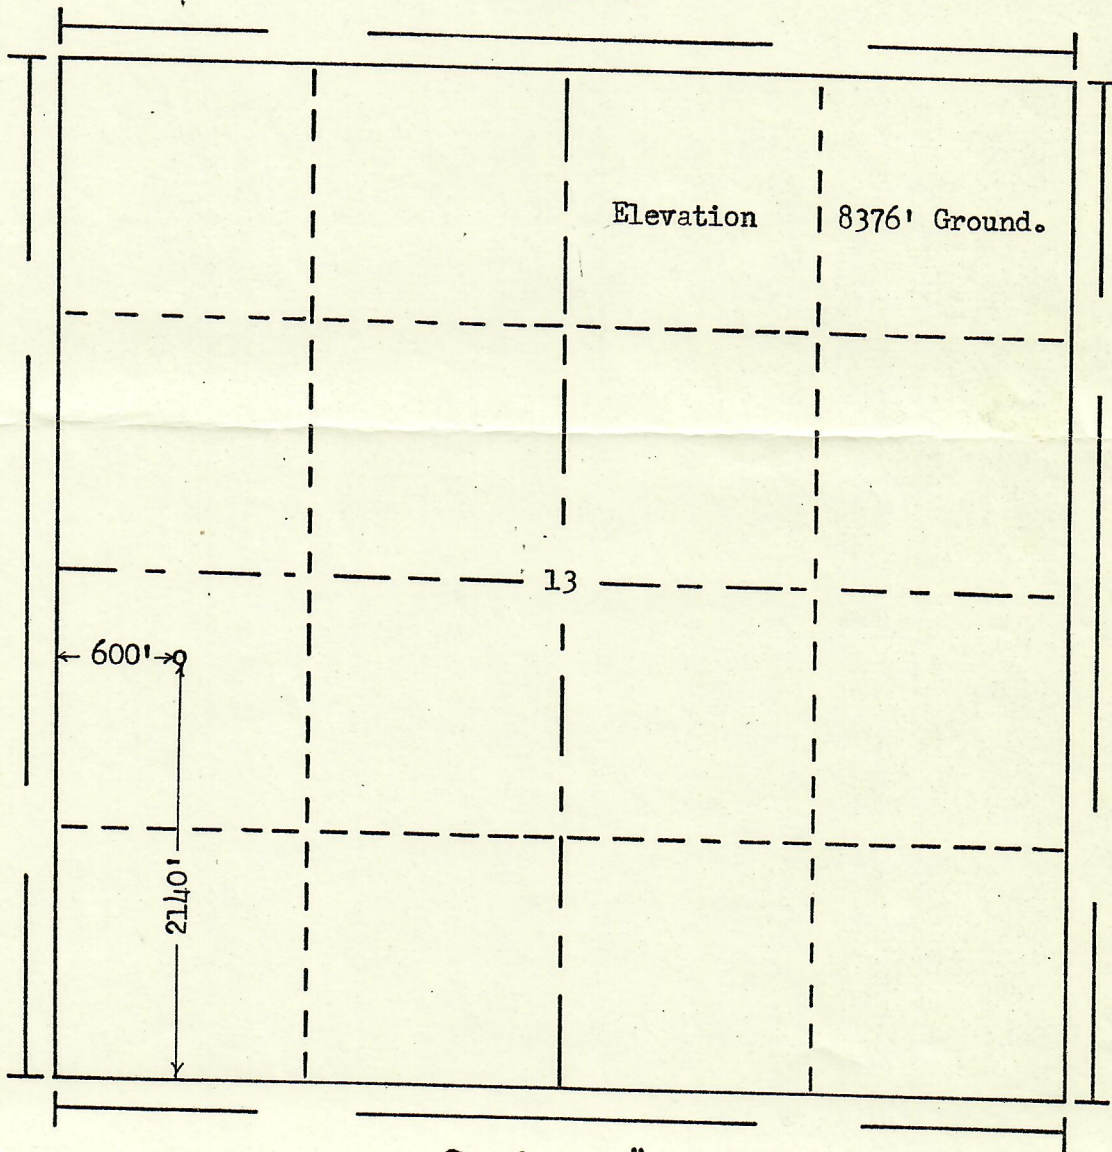

Scale... 1" = 1000'

Powers Elevation Company, Inc. of Denver, Colorado
has in accordance with a request from Robert Grady
for Cities Service Oil Company

determined the location of
to be 2140' FS & 600' FW
Range 82 W. of the 6th Principal
Jackson County,

#1 Chedsey-A
Section 13 Township 7 N.
Meridian
Colorado

I hereby certify that this plat is an
accurate representation of a correct
survey showing the location of
#1 Chedsey-A

Date: 11-15-72

Nelson K. Kelle
Licensed Land Surveyor No. 4843
State of Colorado