



00216396


Oilwell location  
for  
Empire Drilling Co.  
Jackson County, Colorado  
Colorado State Forest

RECEIVED

FEB 21 1978

COLO. OIL &amp; GAS CONS. COMM

T7N R77W 6PM

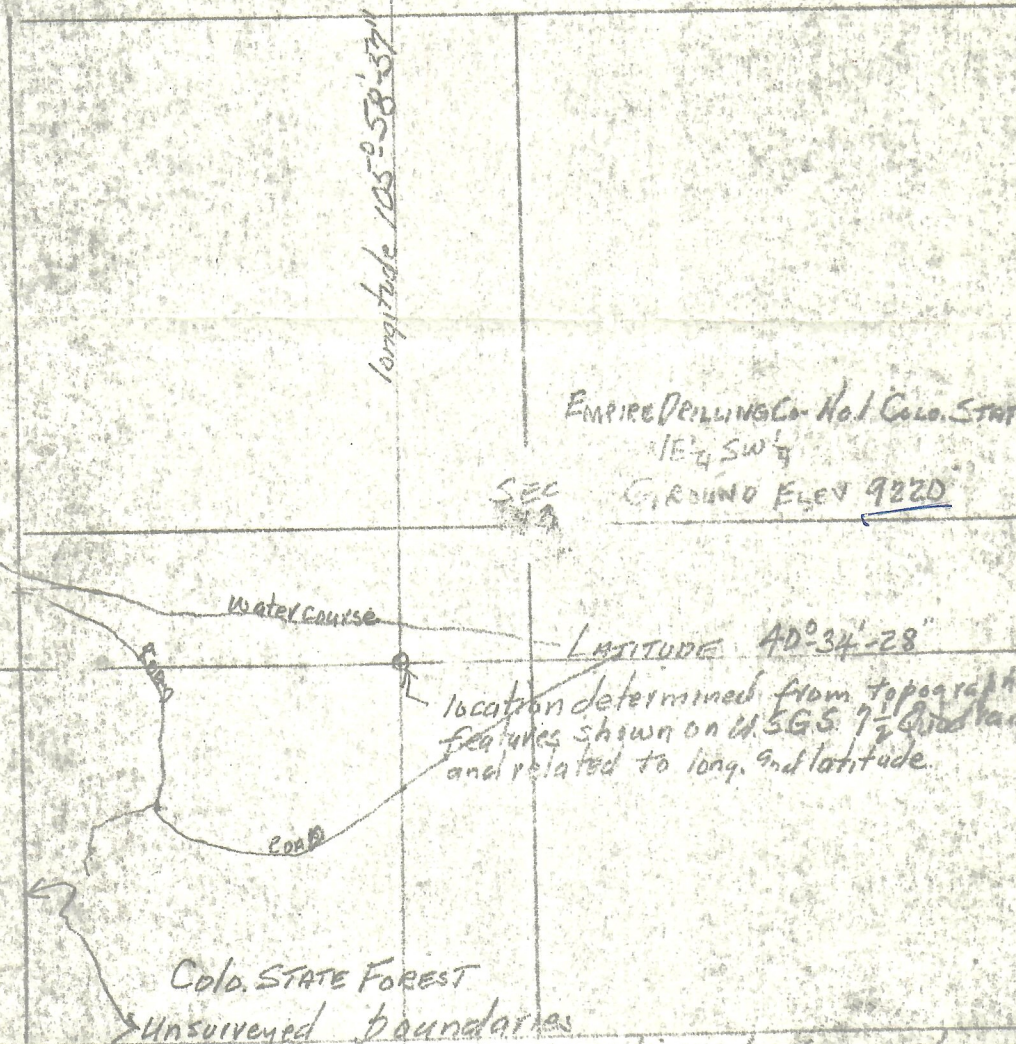

SCALE: 1" = 1000'

BEST COPY AVAILABLE

Colo. STATE Forest  
Unsurveyed boundaries  
Section shown schematic only from extensions from surveyed area

The above plat is a projection of the possible extension of the exterior of Sec. 13 T7N R77W 6PM which at present is unsurveyed based upon the U.S.G.S. 7 1/2" Quadangle Gould approximating a NE 1/4 SW 1/4 Sec. 13 T7N R77W 6PM location. The location fixed Lat. and long. was made from field work from road intersection and drainage location as shown on the quadrangle. The elevation was taken from the same intersection.

Fort Morgan, Colorado  
May. 23, 1977

*Beaumont*  
Registered Professional Engineer  
State of Colorado