



00216391

Oilwell location
for
Empire Drilling Co.
Jackson County, Colorado
Colorado State Forest

RECEIVED

SEP 2 1977


COLD OIL & GAS CONS. COMM.

T7N R77W 6PM

BEST IMAGE
AVAILABLE

EMPIRE DRILLING CO. No. 1 Colo. STATE FOREST Oilwell
NE $\frac{1}{4}$ SW $\frac{1}{4}$
SEC 13
GROUND ELEV 9220

SCALE 1" = 1000'

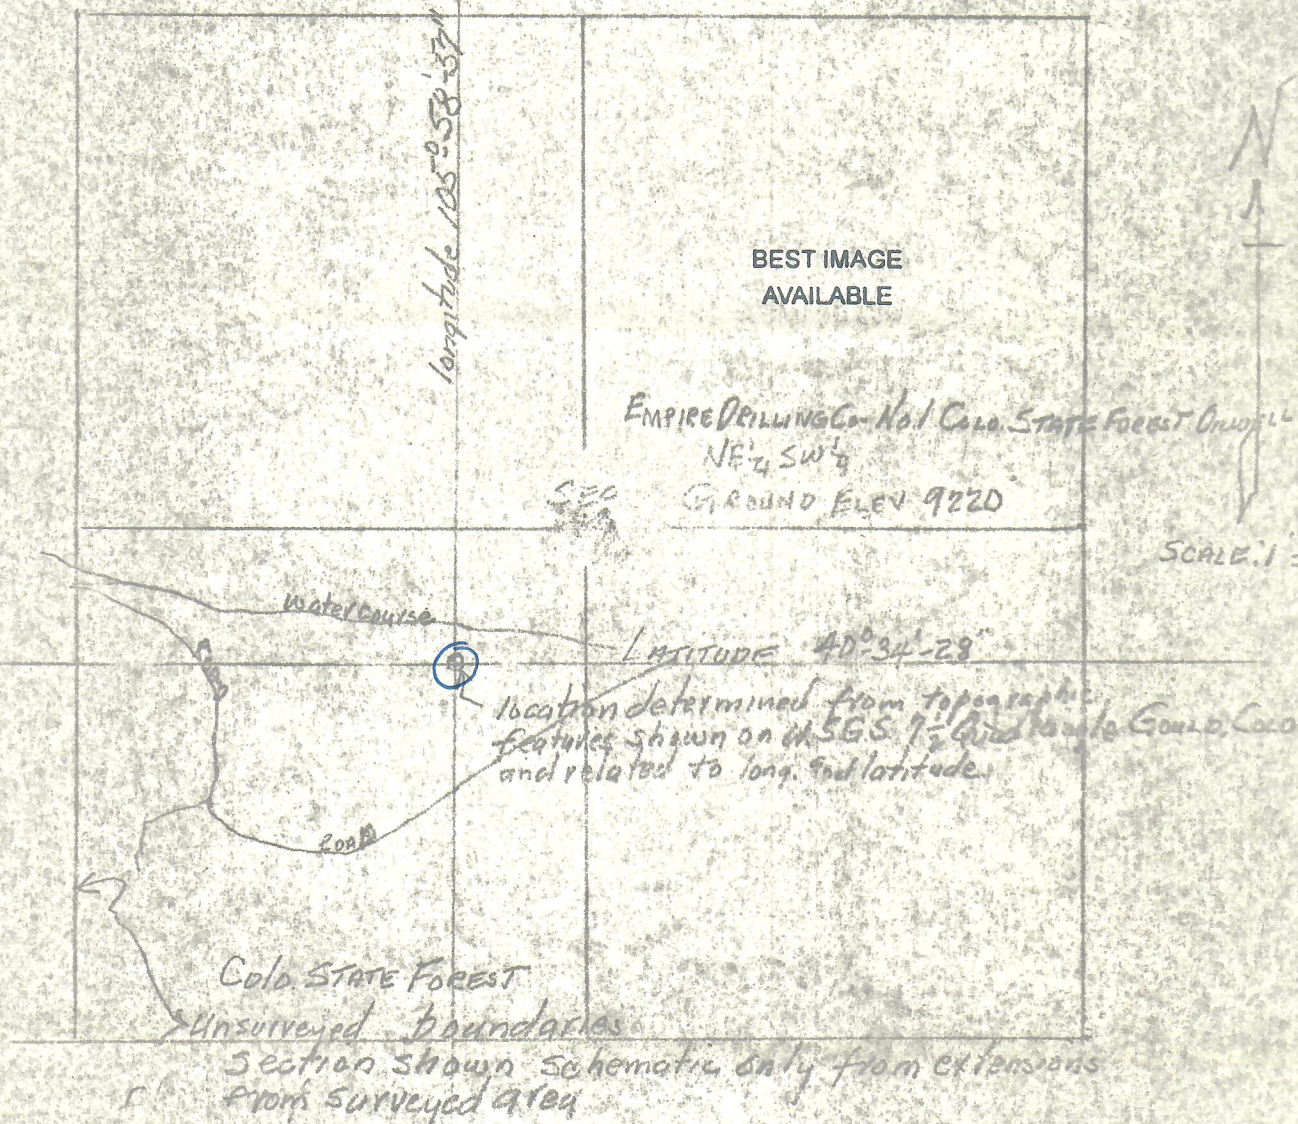

The above plat is a projection of the possible extension of the exterior of Sec. 13 T7N R77W 6PM which at present is unsurveyed based upon the U.S.G.S. 7 $\frac{1}{2}$ ' Quadrangle Gould approximating a NE $\frac{1}{4}$ SW $\frac{1}{4}$ Sec. 13 T7N R77W 6PM location. The location fixed Lat. and Long. was made from field work from road intersection and drainage location as shown on the quadrangle. The elevation was taken from the same intersection.

Fort Morgan, Colorado
May 23, 1977

Cecil J. Abner
Registered Professional Engineer
State of Colorado