




00247225

RECEIVED

NOV 13 1968

R. 52W

COLO. OIL & GAS CONS. COMM.

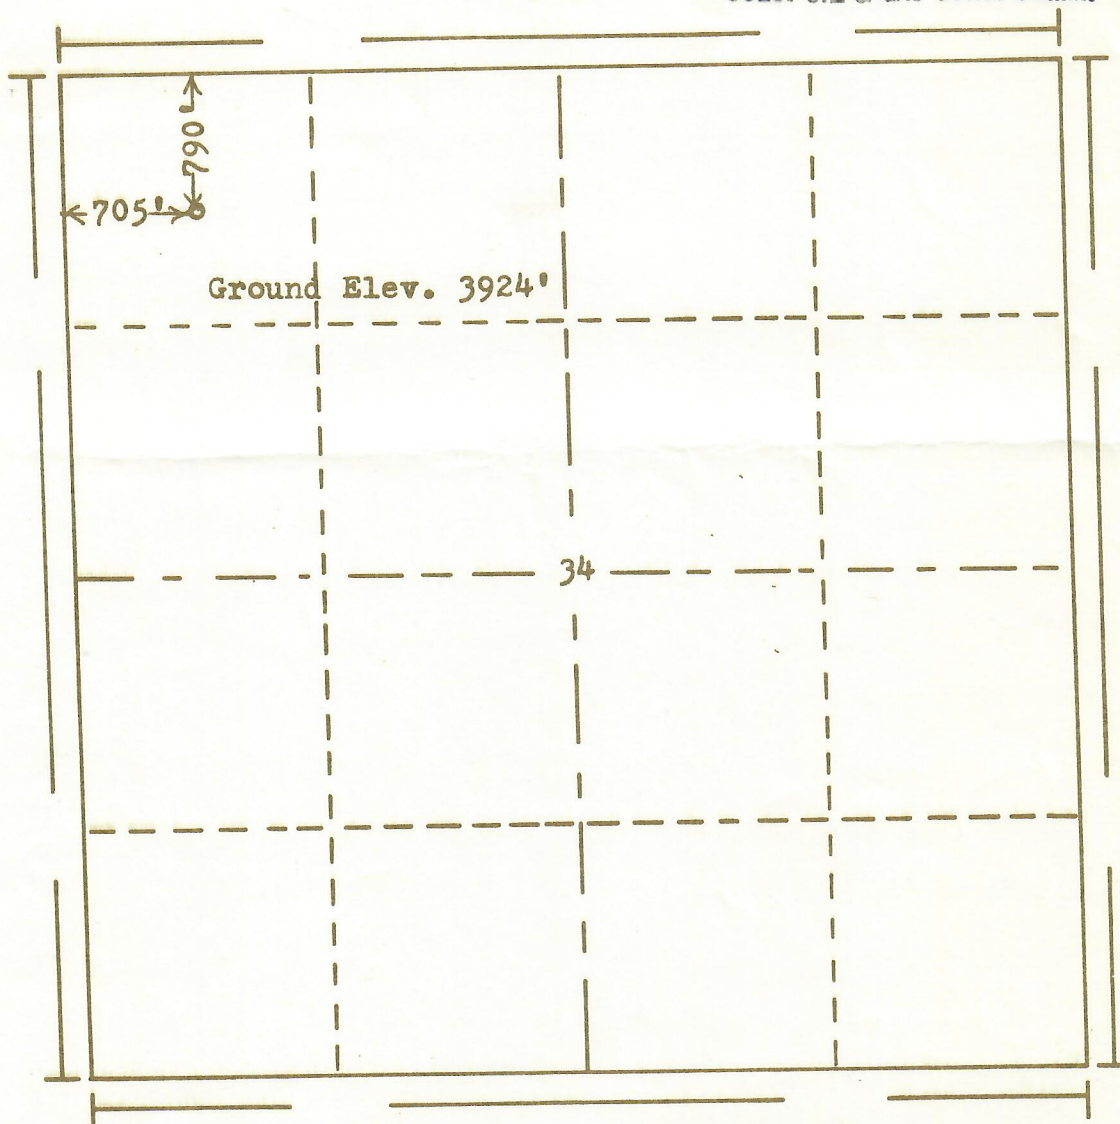

Scale... 1" = 1000'

Powers Elevation Company, Inc. of Denver, Colorado
has in accordance with a request from Mr. Miller
for K&M Associates
determined the location of No.1 Cloverleaf-State
to be 705'FN & 790'FN Section 34 Township 8N
Range 52W of the 6th Principal Meridian
Logan County, Colorado

I hereby certify that this plat is an
accurate representation of a correct
survey showing the location of

Date: 10-17-68

Billy G. Hollen
Licensed Land Surveyor No. 2853
State of Colorado