



# SECTION PLAT

RECEIVED

SEP 10 1970

COLO. OIL & GAS CONS. COMM.

LOGAN

County, State of


COLORADO

Section 24

Township 8 North

Range 52 West

NORTH

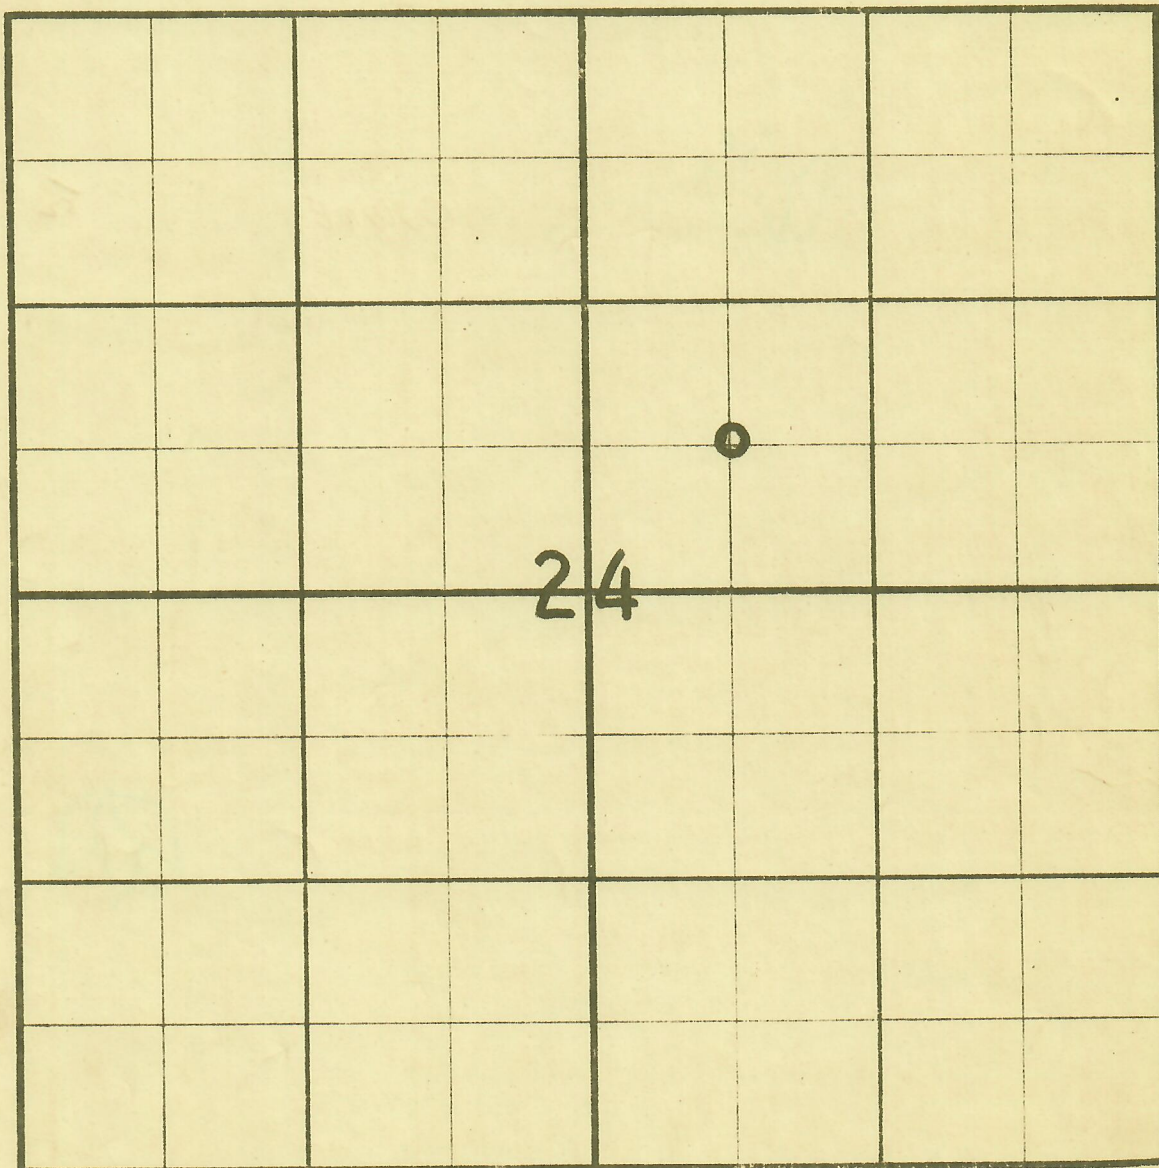

Plat showing Location of  
Davidor & Davidor, Inc. State No. 1 - 24  
1980' from East and North Lines of  
Section 24 - 8N - 52 W