




00247080

RECEIVED

MAY 20 1970

COLO. OIL & GAS CONS. COMM.

R. 52W

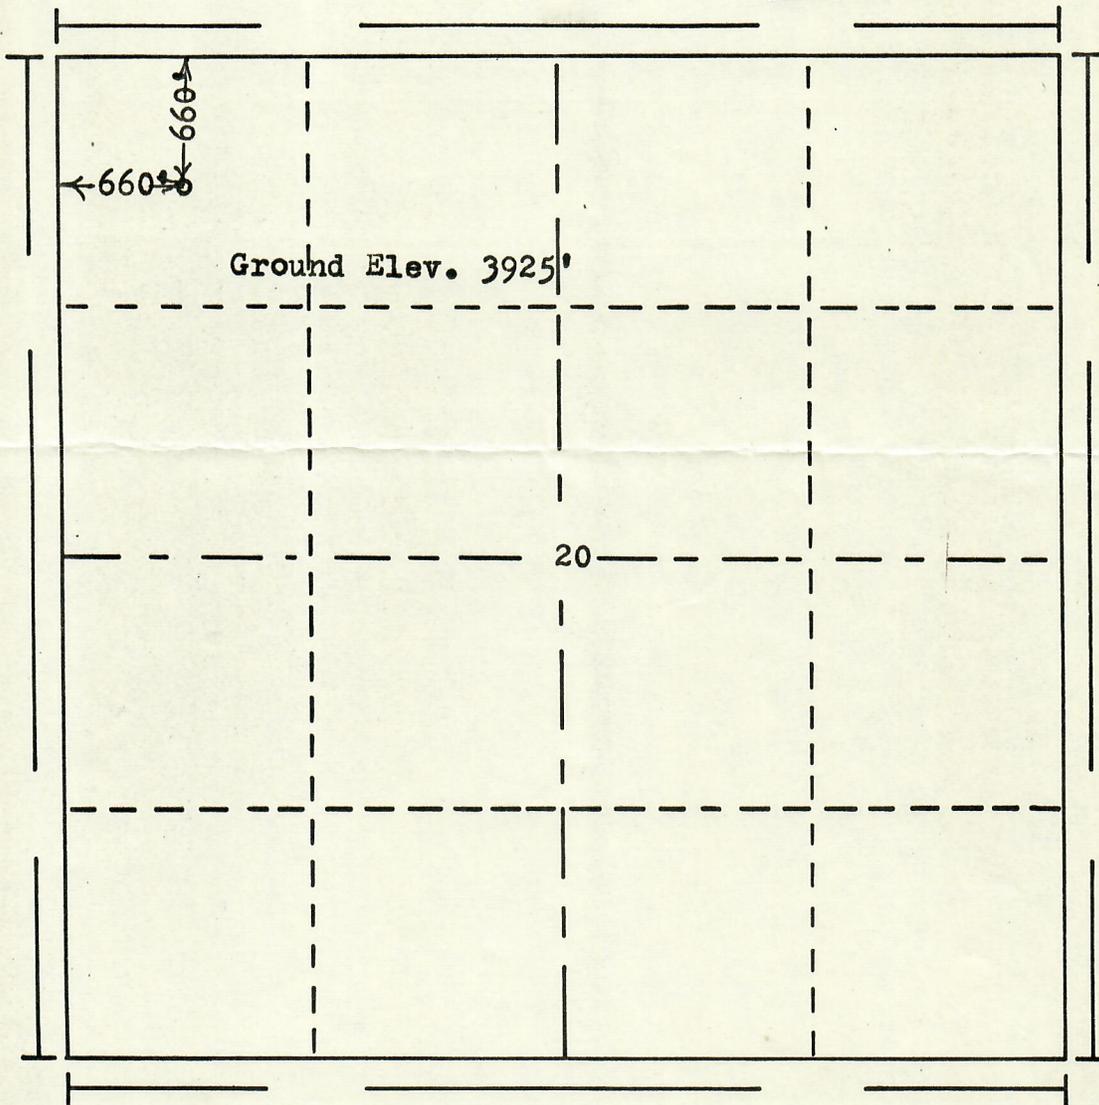

T.
8
N

Scale... 1" = 1000'

Powers Elevation Company, Inc. of Denver, Colorado has in accordance with a request from Mr. Gear for Knight & Miller Oil Corp.

determined the location of No.1 Rinaldo to be CNW NW Section 20 Township 8N Range 52W of the 6th Principal Meridian Logan County, Colorado

I hereby certify that this plat is an accurate representation of a correct survey showing the location of

Date: 5-14-70

B. J. Hollaway
Licensed Land Surveyor No. 2853
State of Colorado