

# Foundation Energy Management, LLC

## WELLBORE DIAGRAM

| Well / Battery | Prospect Name      |  | Total Depth       | Current Status |
|----------------|--------------------|--|-------------------|----------------|
|                | Ekberg John H 2-34 |  |                   | Plugged        |
|                |                    |  | Producing Horizon | County & State |
|                |                    |  |                   | YUMA CO        |

## WELLBORE DIAGRAM

**Prepared Date:** 10/31/2019

**Prepared By:** Mike Bohler

### General Info

API #: 05-125-06117

KB Elevation:

GL Elevation:

Spud Date:

Completion Date:

TVD:

MD:


Last PBTD:

### Tubing Detail

inch(OD)

# (weight)

depth

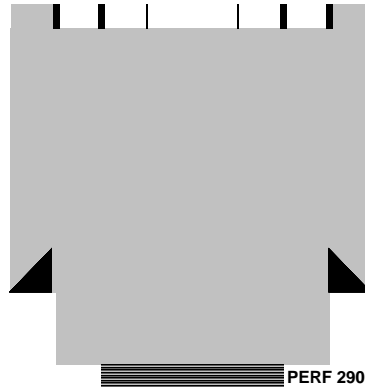

PUMPED 70SKS TO SURFACE

### Surface Casing

7 inch (OD)  
17 # (weight)  
grade  
83 depth from KB  
0 cement top  
30 sacks of cement  
9 7/8 inch (OD) HOLE SIZE

### Production Casing

4.5 inch (OD)  
9.5 # (weight)  
grade  
1692 depth from KB  
900 cement top  
75 sacks of cement  
6 1/4 inch (OD) HOLE SIZE

Pump Details:  
none

Pumping Unit Details:

Well Notes:

TOC: 900

2SKS

CIBP 1550