



FORM F-106



00235026

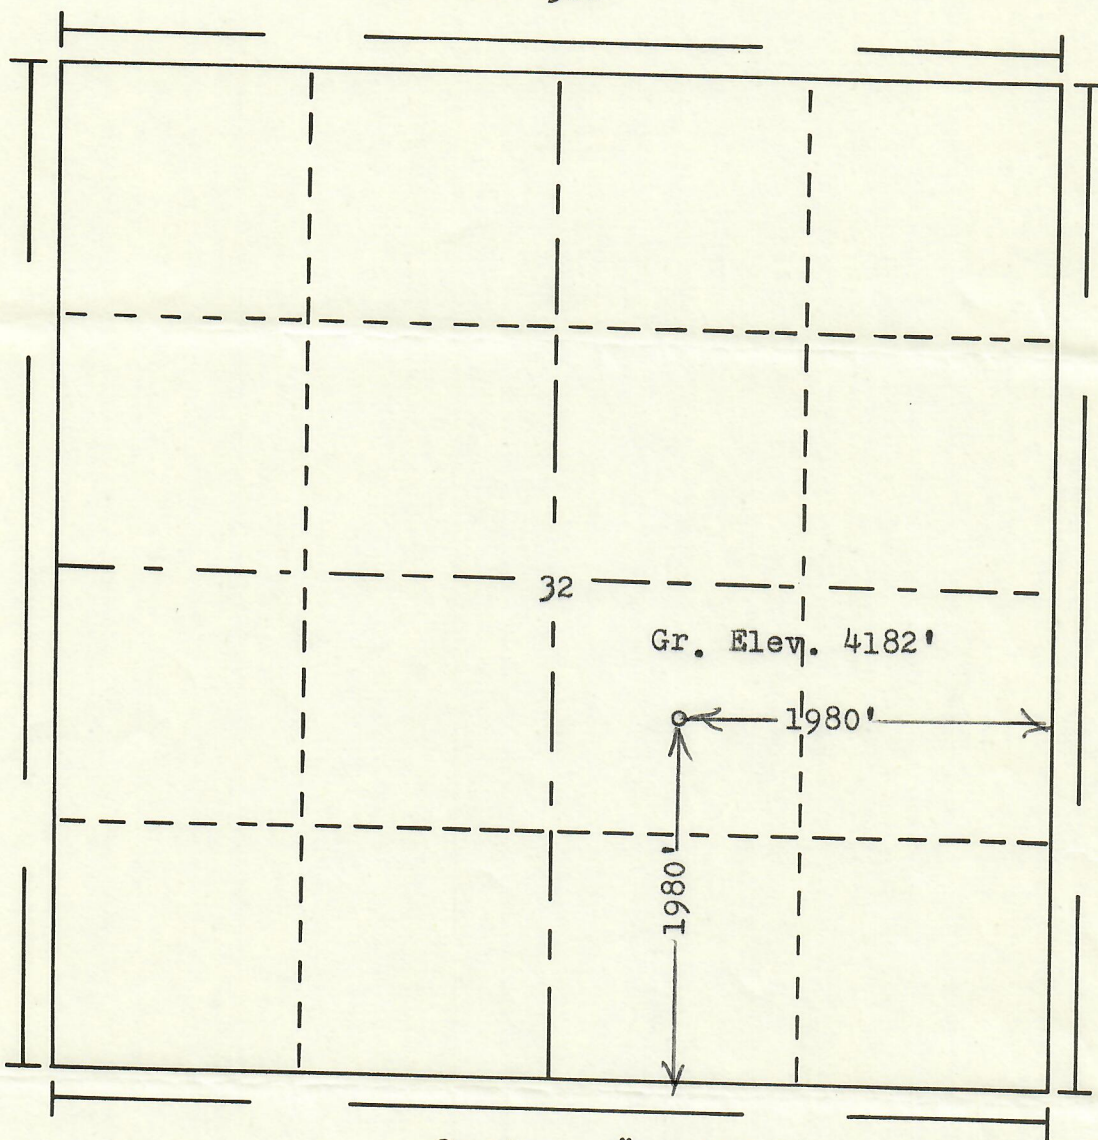
RECEIVED

NOV 17 1977

COLO. OIL & GAS CONS. COMM.

N

R. 51W

T.
8
N

Scale... 1" = 1000'

Powers Elevation Company, Inc. of Denver, Colorado
has in accordance with a request from Mr. Whitaker
for Burlington Northern
determined the location of No. 33-32 State
to be CNW SE Section 32 Township 8N
Range 51W of the 6th Principal Meridian
Logan County, Colorado

I hereby certify that this plat is an
accurate representation of a correct
survey showing the location of

Date: 11-4-77

B. J. Hallman
Licensed Land Surveyor No. 2853
State of Colorado