



Legend

-  Excavation Extent
-  Soil Sample Location

Notes

All locations are approximate unless otherwise noted.

Surface drainage direction is estimated based on topography and is not related to regional topography.

0 ft. 10 ft. 20 ft.

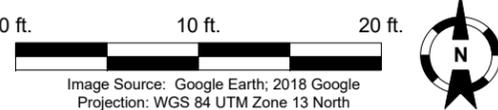


Image Source: Google Earth; 2018 Google
Projection: WGS 84 UTM Zone 13 North

DATE:	January 6, 2020
DESIGNED BY:	C. Hamlin
DRAWN BY:	B. Nelson



Tasman Geosciences, Inc.
6855 W. 119th Ave.
Broomfield, CO 80020

PDC Energy, Inc. – DJ Basin
Former Marie 1-23 Tank Battery
SESW, Section 23, Township 5 North, Range 65 West
Weld County, Colorado

EXCAVATION SITE MAP

FIGURE
1