



FORM F-106

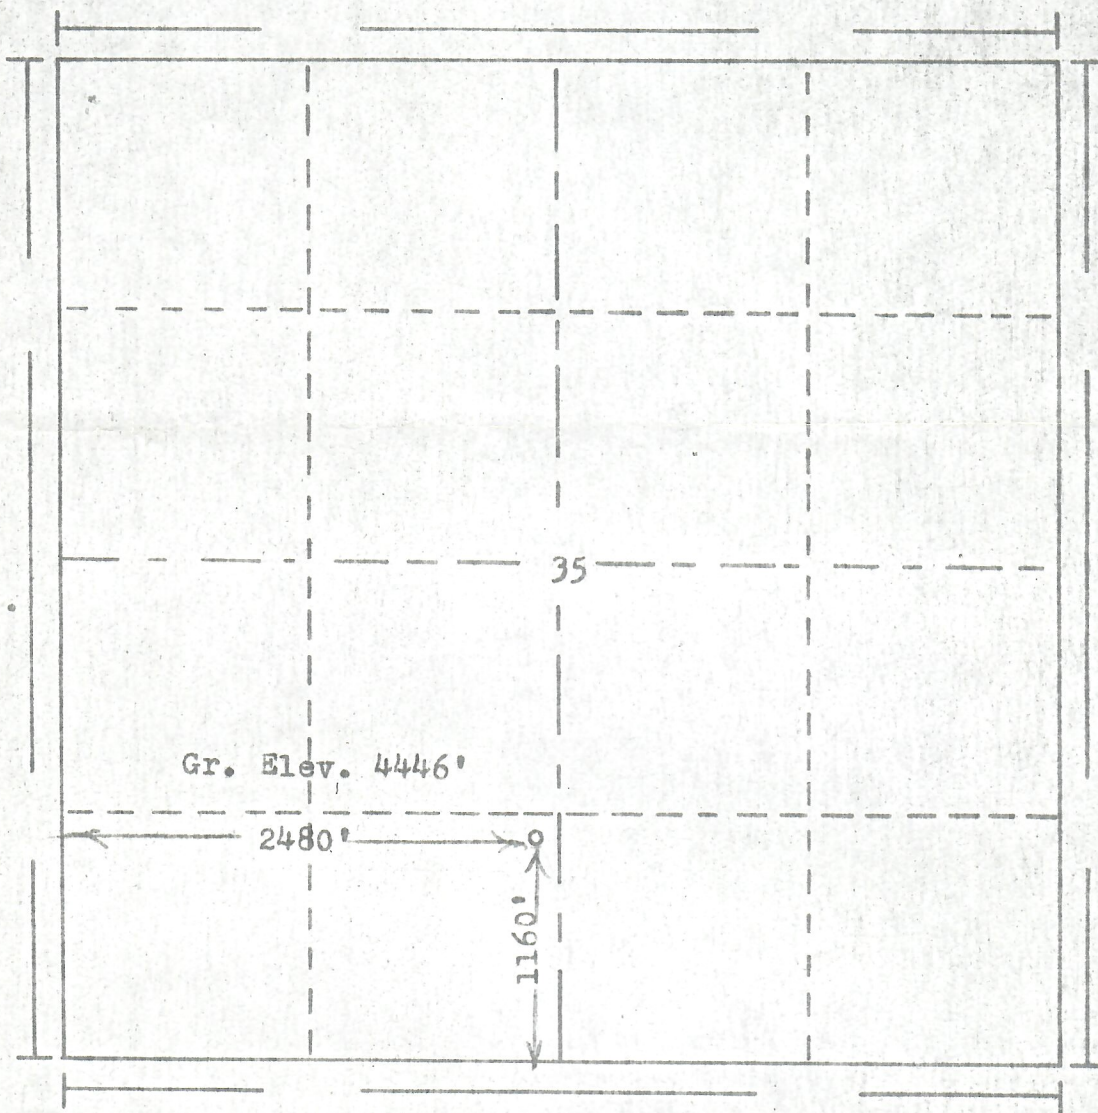


RECEIVED

DEC 26 1978

COLO. OIL & GAS COM. CHART

R. 51W

T.
8
N1320
1160
160

Scale... 1" = 1000'

Powers Elevation Company, Inc. of Denver, Colorado
has in accordance with a request from Mr. Lukowicz
for Ladd & Lukowicz

determined the location of No. 1-35 State
to be 1160'FS & 2480'FW Section 35 Township 8N
Range 51W of the 6th Principal Meridian
Logan County, Colorado

I hereby certify that this plat is an
accurate representation of a correct
survey showing the location of

Date: 12-15-78

B. J. [Signature]
Licensed Land Surveyor No. 2853
State of Colorado