


**Well Name: RODRIGUEZ 17-32**

VERTICAL, ORIGINAL HOLE, 1/7/2020 7:57:49 AM

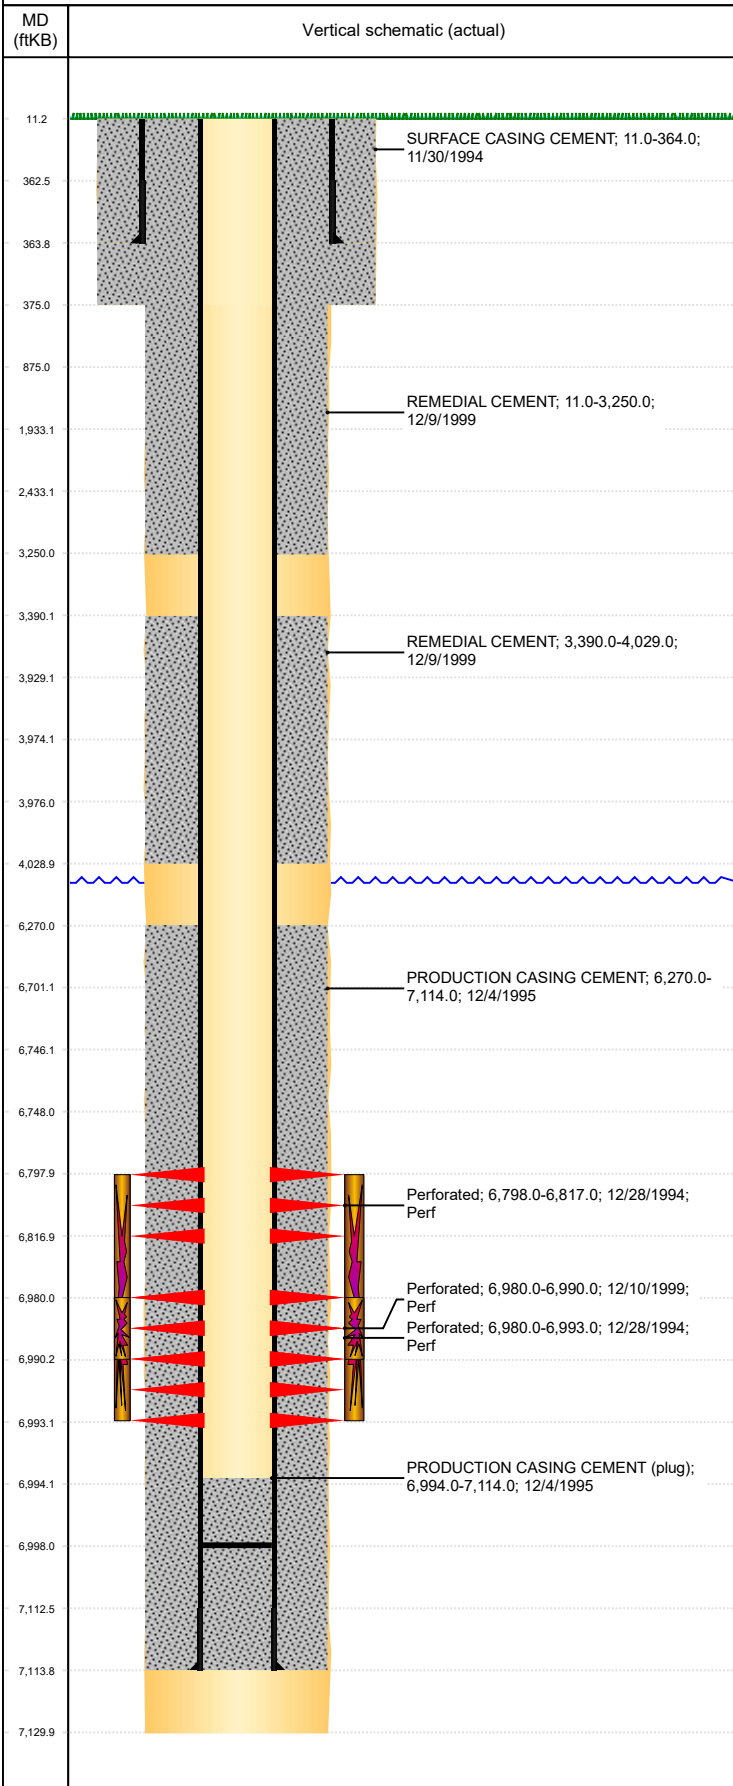

Well Header									
API 05-123-18641		Business Unit DJ BASIN			District 15		Well Config VERTICAL		
KB - GL / MSL (ft... 11.00		Spud Date 11/30/1994		P & A Date		Well Production Status PR			SoRT No
Comment									
Surface Location (Congressional)									
Qtr 3 NW	Qtr 4 SW	Section 17	Twnshp 6	Twnsh... N	Range 64	Rng E/... W	Actual Latitude (°) 40.48354000	Actual Longitude (°) -104.58176000	
Wellbore Sections									
Section Des			Size (in)			Act Top, MD (ftKB)		Act Btm, MD (ftKB)	
SURFACE			12 1/4			11		375	
PRODUCTION			7 7/8			375		7,130	
Casing Strings									
Csg Des			Run Date	OD (in)	Wt/Len (lb/ft)	Grade	Top, MD (ftKB)	MD (ftKB)	
Surface			11/30/1994	8 5/8	24.00	J-55	11.0	364.0	
Production			12/4/1994	3 1/2	7.70	LC-70	11.0	7,114.0	
Cement									
Des					Start Date		Top (ftKB)		Btm (ftKB)
SURFACE CASING CEMENT					11/30/1994		11.0		364.0
PRODUCTION CASING CEMENT					12/4/1995		6,270.0		7,114.0
REMEDIAL CEMENT					12/9/1999		11.0		3,250.0
REMEDIAL CEMENT					12/9/1999		3,390.0		4,029.0
Zone Statuses									
Zone Name	Status Date	Status	Fluid Type	Job				Prod Method	
CODELL	12/18/1999	PR	Oil	RE-FRAC, 12/2/1999 00:00				Flowing	
CODELL	5/4/2010	PR	Water						
NIOBRARA	1/6/1995	PR	Oil	DRILLING/COMPLETION - ORIGINAL, 11/30/199...				Flowing	
NIOBRARA	5/4/2010	PR	Water						
NIOBRARA-CO...	5/4/2010	PR	Water					Flowing	
NIOBRARA-CO...	5/30/2017	PR							
Perforation Data									
Linked Zone			Bnch/Stg	Entered Shot Total	Top (ftKB)		Btm (ftKB)		Date
NIOBRARA, ORIGINAL HOLE				8	6,798.00		6,817.00		12/28/1994
CODELL, ORIGINAL HOLE				40	6,980.00		6,990.00		12/10/1999
CODELL, ORIGINAL HOLE				8	6,980.00		6,993.00		12/28/1994
Stimulation Intervals									
Zone					Start Date		Top (ftKB)		Btm (ftKB)
NIOBRARA-CODELL, ORIGINAL HOLE					12/28/1994		6,798.0		6,993.0
CODELL, ORIGINAL HOLE					12/15/1999		6,980.0		6,990.0
Other In Hole									
Run Date		Des				OD (in)	Top (ftKB)		Btm (ftKB)
Logs									
Date		Type					Top, MD (ftKB)		Btm, MD (ftKB)
12/4/1994		COMPENSATED DENSITY					330.0		7,145.0
12/4/1994		INDUCTION					330.0		7,145.0
12/9/1994		CBL/CCL/GR					6,182.0		6,990.0
Plug Back Total Depths									
Date		Type			Com				Depth (ftKB)
12/9/1994		FILL			DEPTH LOGGER FROM CBL				6,994.0
2/11/2013		FILL			BAILED DOWN TO 6998'				6,998.0