


PetroShare Corp  
RMPCO Kissler #2  
0512323527  
21-4N-66W (NWNW)  
spud 5/4/2006 completed 5/9/2006

Wellbore Diagram January 10, 2020

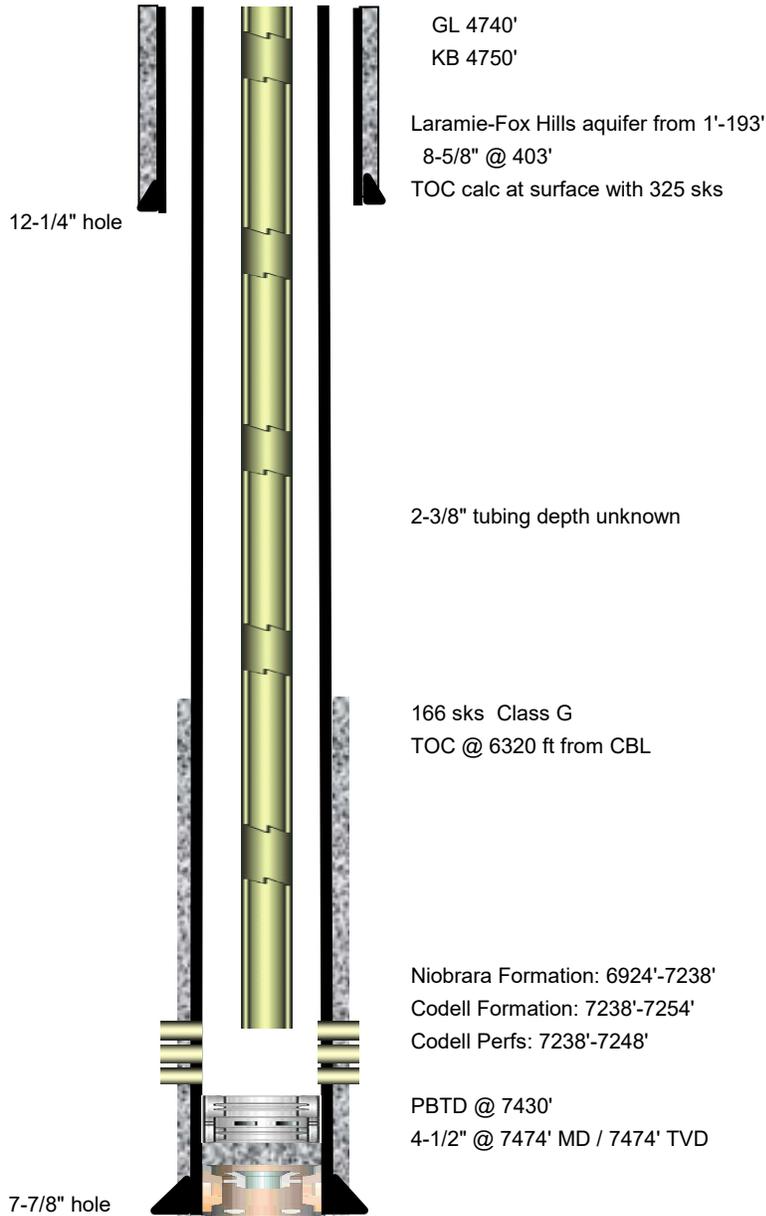

not to scale