




00226981

RECEIVED

MAR 17 1969

COLO. OIL & GAS CONS. COMM.

R. 51 W

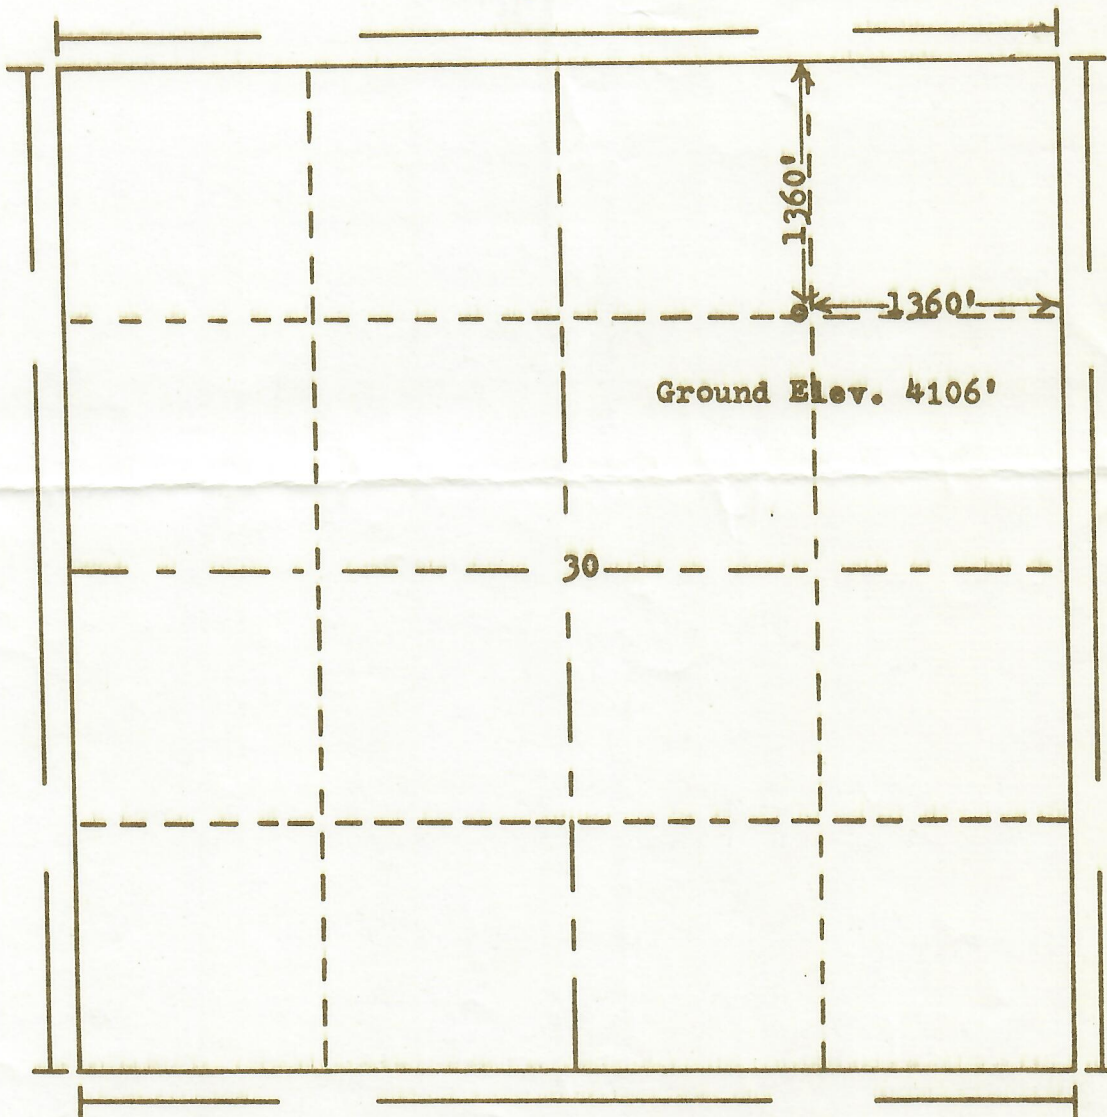

Scale... 1" = 1000'

Powers Elevation Company, Inc. of Denver, Colorado
has in accordance with a request from Mr. Abel
for Chancellor Exploration & Exeter Drilling Co.
determined the location of No. 1 State follow-up
to be 1360' FN & 1360' FE Section 30 Township 8 North
Range 51 West of the 6th Principal Meridian
Logan County, Colorado

I hereby certify that this plat is an
accurate representation of a correct
survey showing the location of

Date: 3-11-69

B. J. H. H. H.
Licensed Land Surveyor No. 2853
State of Colorado

69-106