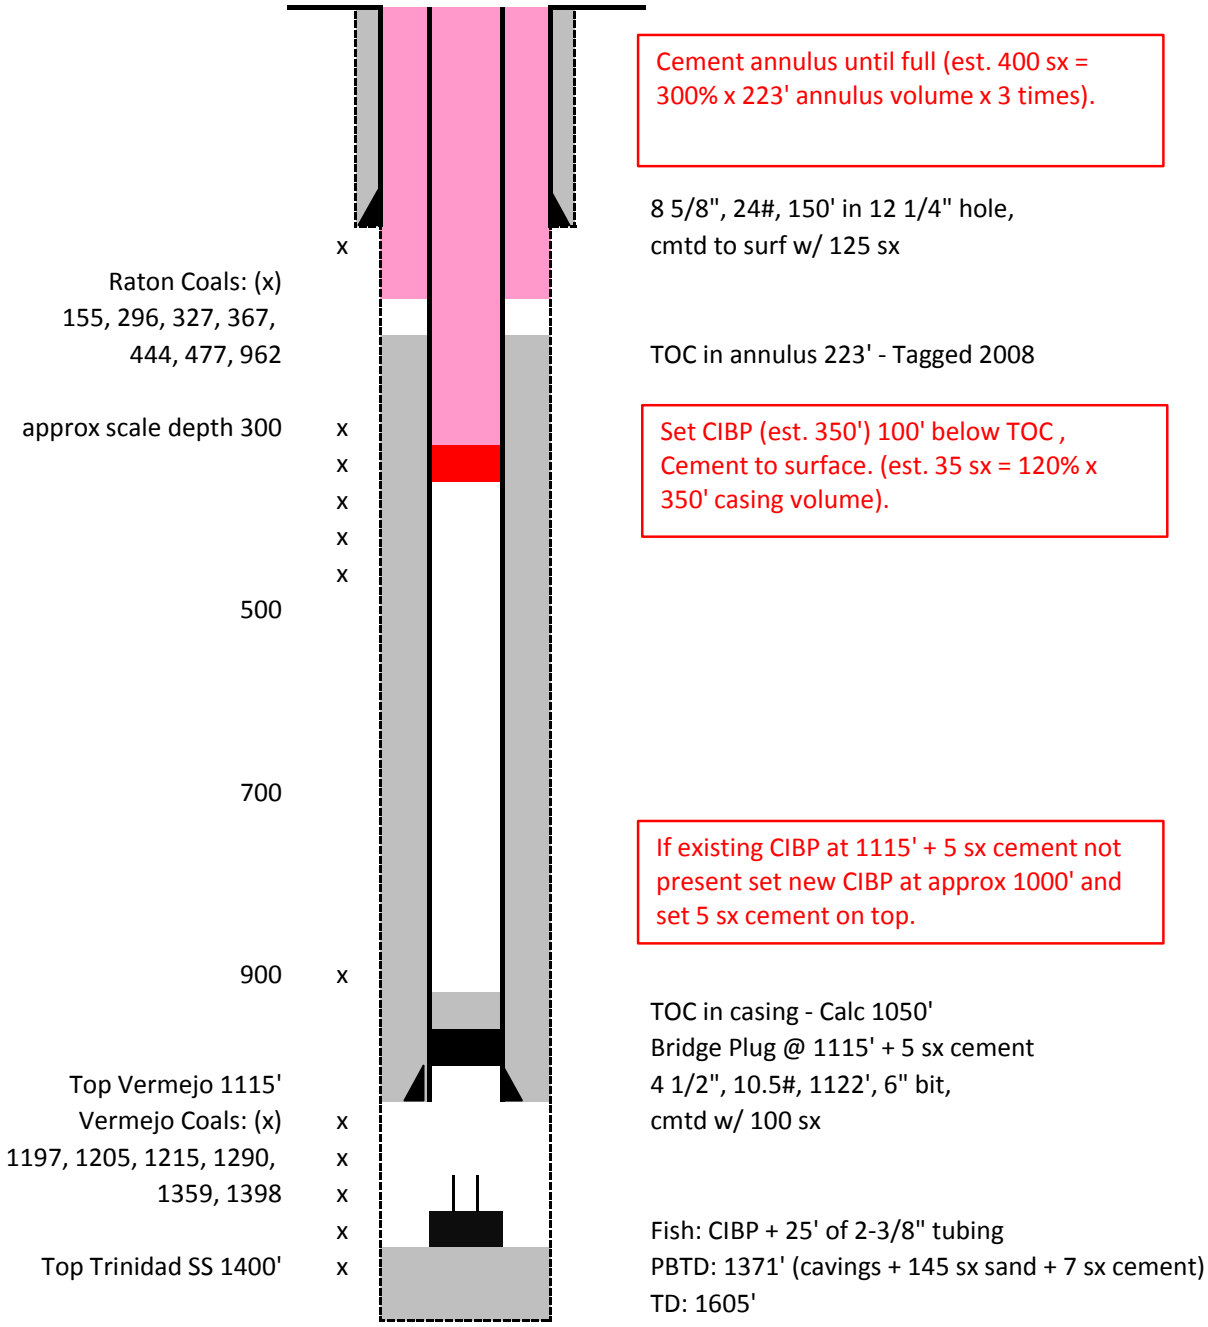Trinidad MGP #1
071-06045
NWNW 32-T33S-R66W
Proposed