


7N-64W-22

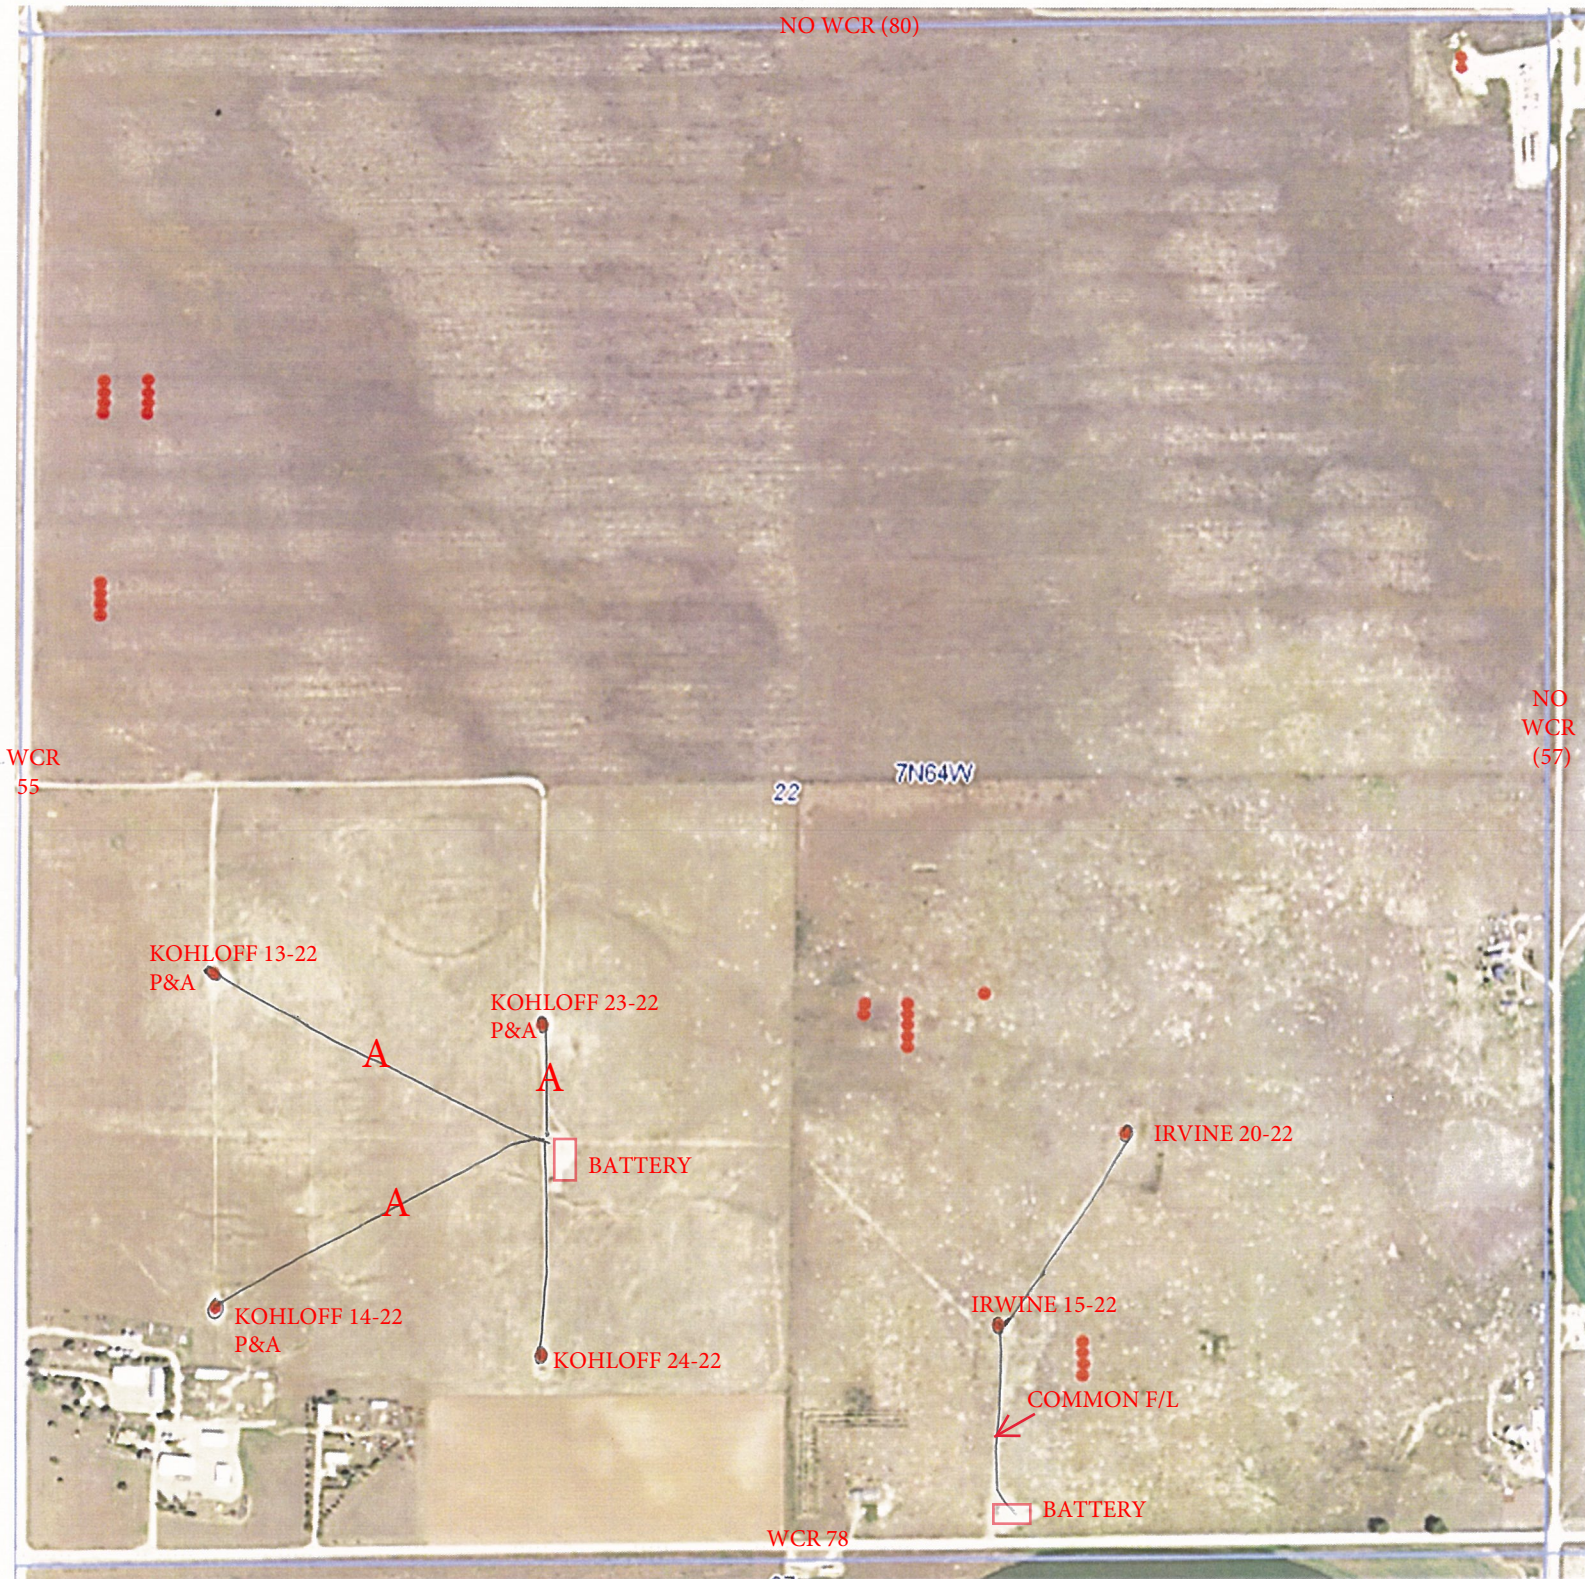

KOHLOFF 23-22 P&A 2/18 ABANDONED F/L  
KOHLOFF 13-22 P&A 4/18 ABANDONED F/L  
KOHLOFF 14-22 P&A 7/18 ABANDONED F/L