

Foundation Energy Management, LLC

WELLBORE DIAGRAM


Well / Battery Blach 1-24	Prospect Name	Total Depth	Current Status
Location	Sec-Twn-Rng	Producing Horizon	County & State

WELLBORE DIAGRAM

Prepared Date: 1-3-2020
Prepared By: Mike Bohler

General Info

API #: 05-125-06159
 KB Elevation:
 GL Elevation:
 Spud Date:
 Completion Date:
 TVD:
 MD:
 Last PBDT:

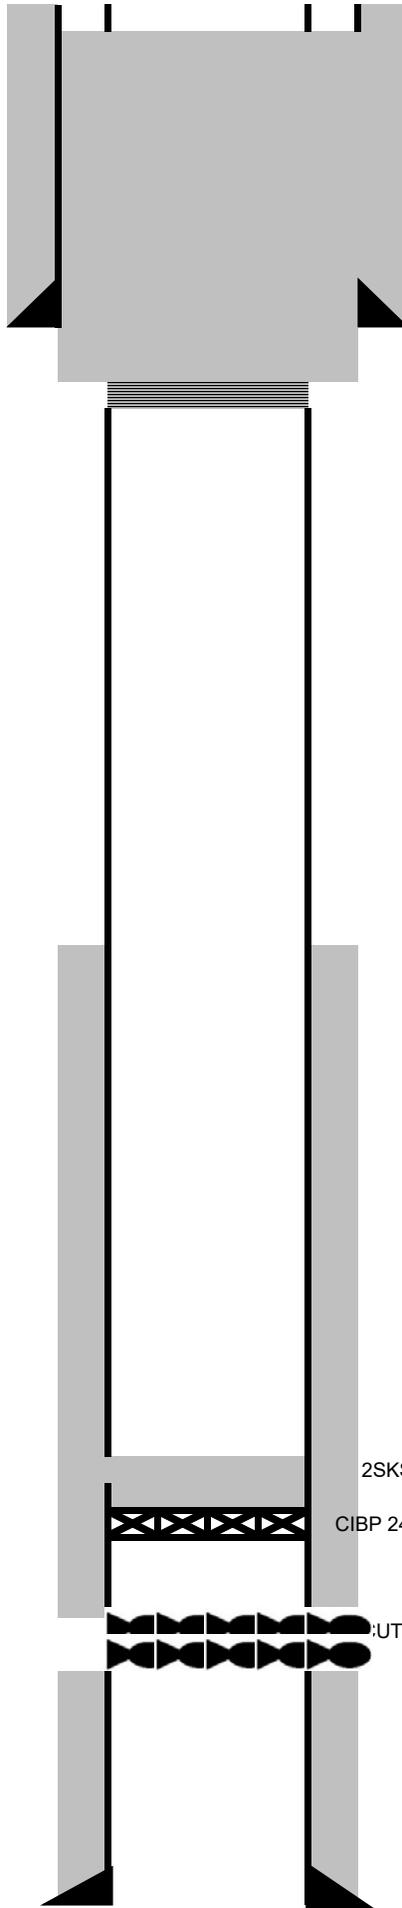

CONDUCTOR CSG

PUMPED 105SKS TO SURFACE

Surface Casing

7 inch (OD)
 24 # (weight)
 grade
 237 depth from KB
 0 cement top Visual Returns
 245 sacks of cement
 9 7/8 inch (OD) HOLE SIZE

Production Casing

4.5 inch (OD)
 10.5 # (weight)
 grade
 2714 depth from KB
 1100 cement top
 150 sacks of cement
 6 1/4 inch (OD) HOLE SIZE
Calculated

Open Perforations

2SKS

CIBP 2424

TUBING 2550

PBDT

TD=