


Zarlengo 23-4 & 24-4 battery

Zarlengo 23-4 & 24-4 central battery

Legend

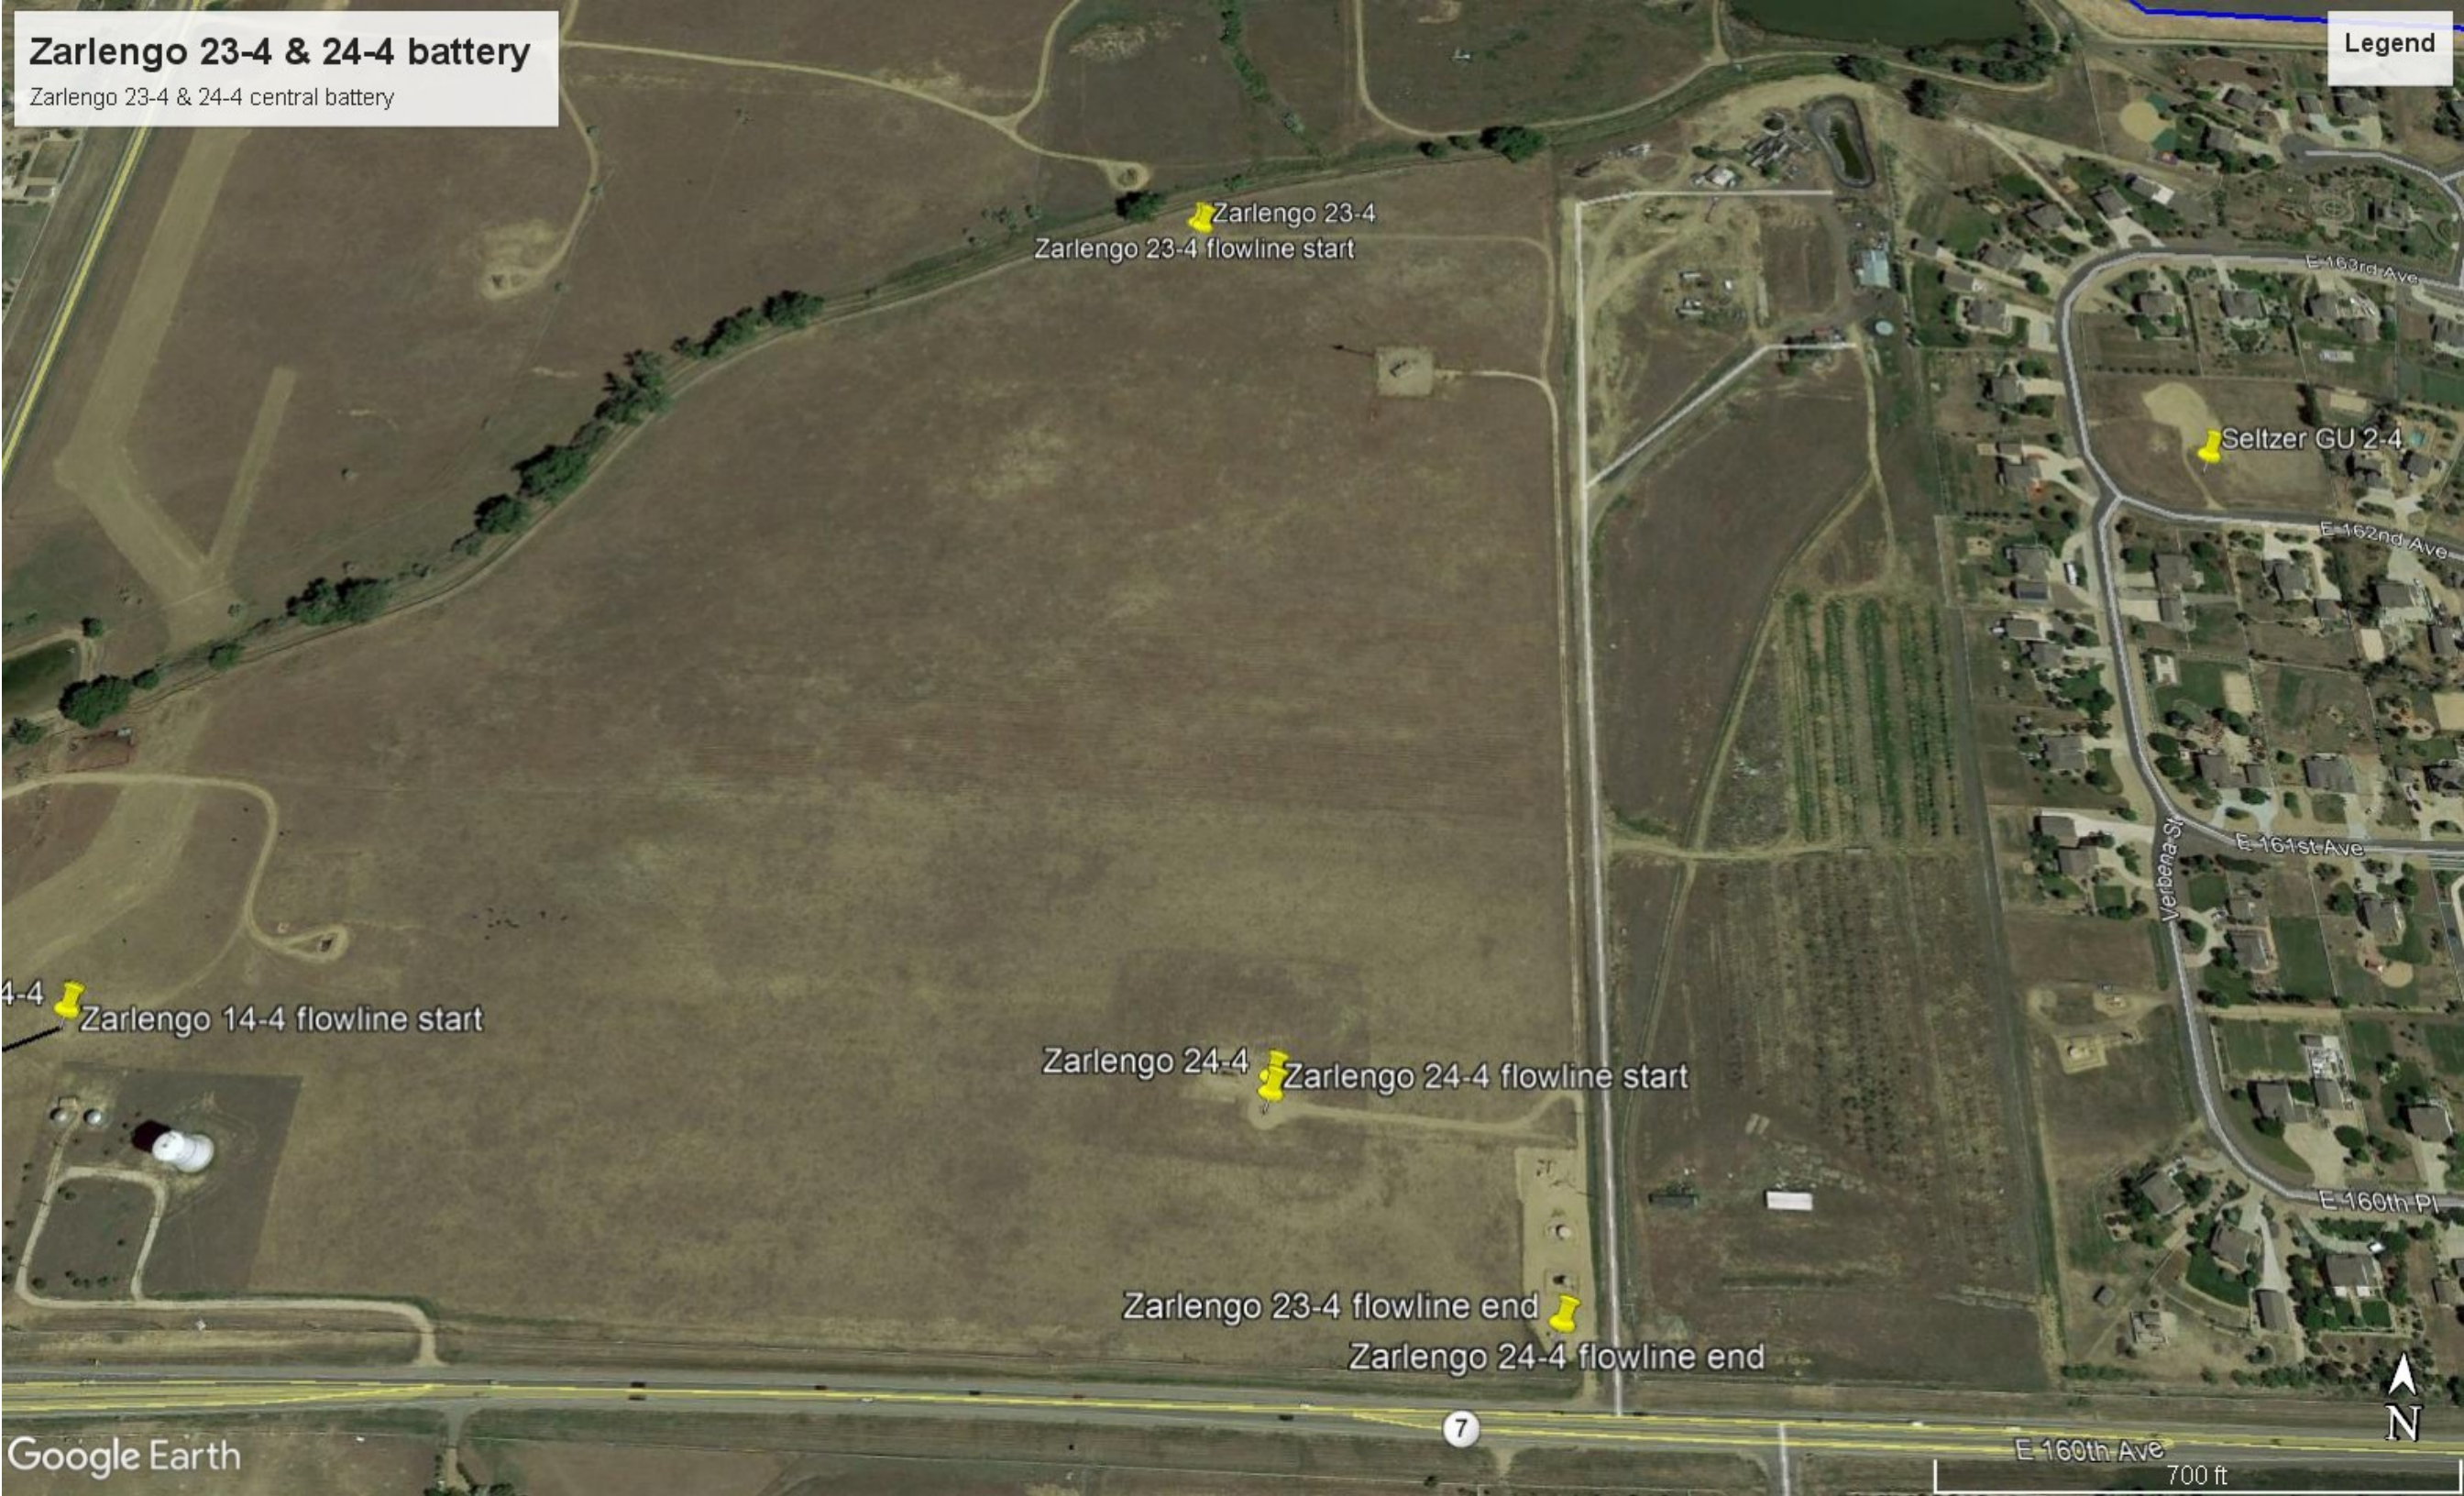

Zarlengo 23-4
Zarlengo 23-4 flowline start

Seltzer GU 2-4

4-4
Zarlengo 14-4 flowline start

Zarlengo 24-4
Zarlengo 24-4 flowline start

Zarlengo 23-4 flowline end
Zarlengo 24-4 flowline end