


6N-65W-8

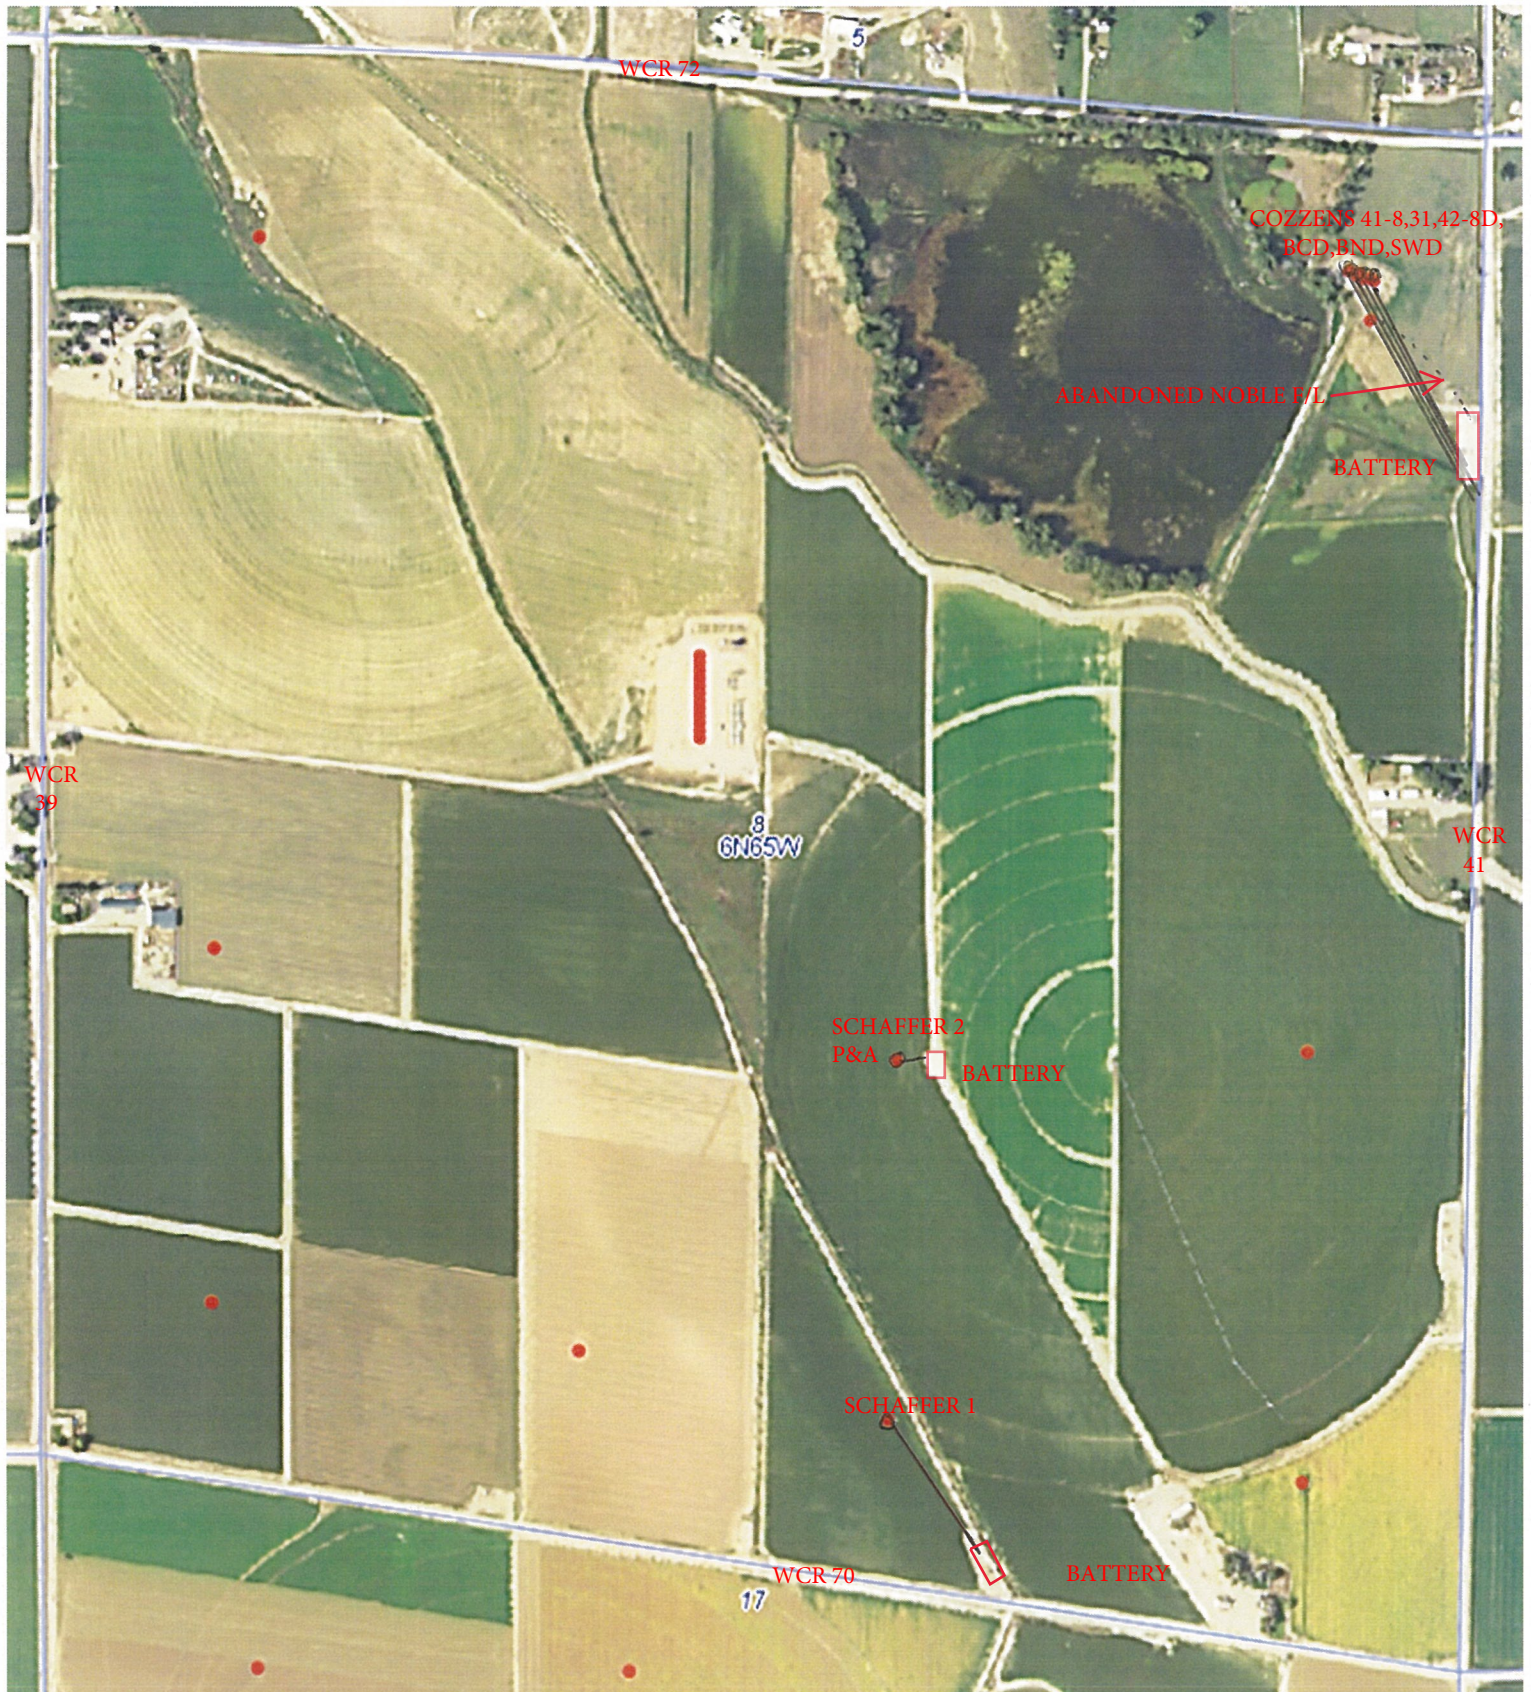

SCHAEFER 2 P&A 4/15 ABANDONED F/L?