



FORM F-106




00284060

RECEIVED

DEC 14 1977

COLO. OIL &amp; GAS CONS. COMM.

R. 56W

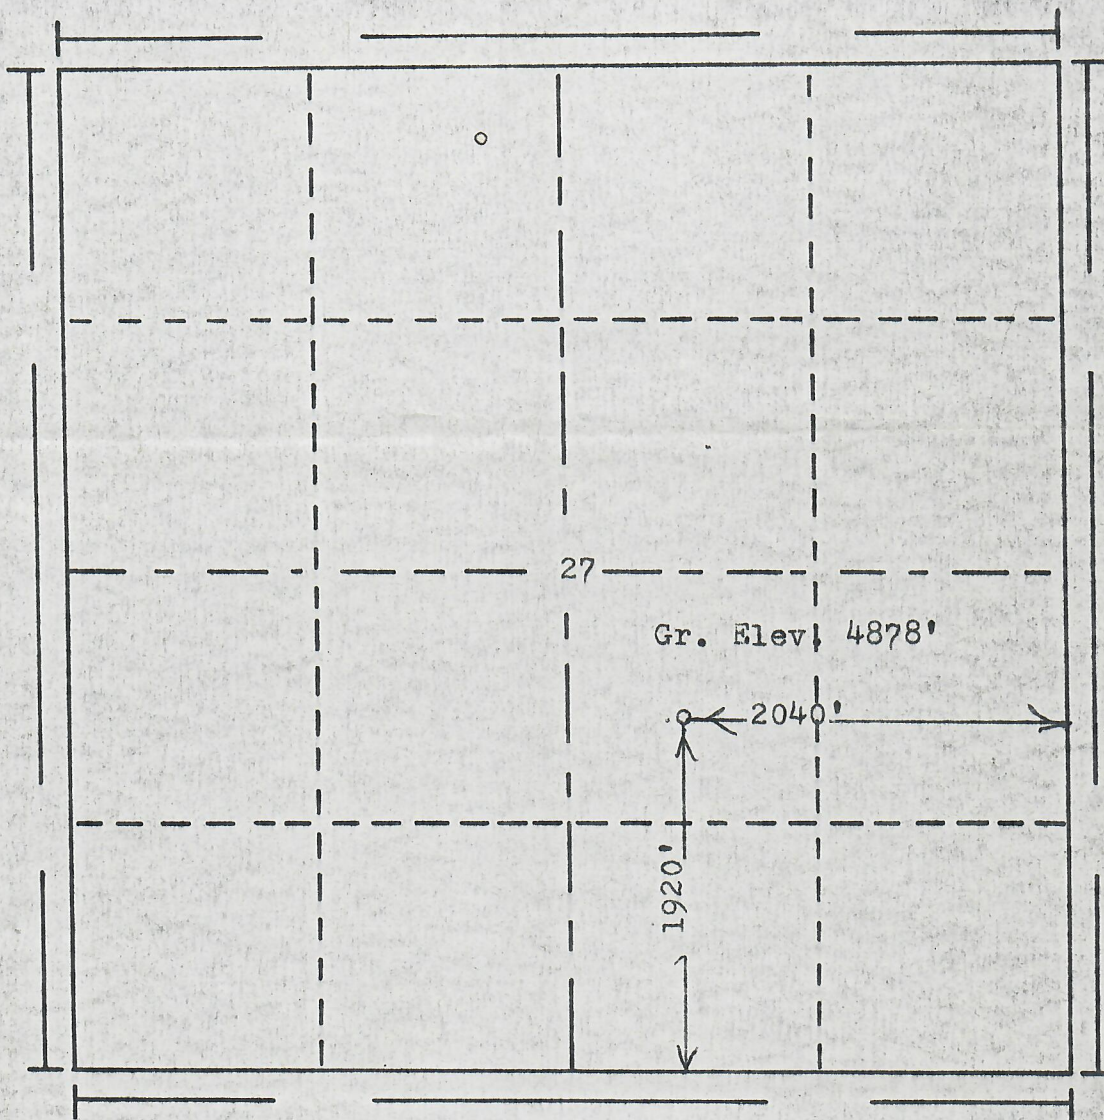

Scale... 1" = 1000'

Powers Elevation Company, Inc. of Denver, Colorado  
has in accordance with a request from Mr. Murphree  
for Beren Corp.

determined the location of No. 1 Buczkowskyj  
to be 1920'FS & 2040'FE Section 27 Township 12N  
Range 56W of the 6th Principal Meridian  
Weld County, Colorado

I hereby certify that this plat is an  
accurate representation of a correct  
survey showing the location of

Date: 9-27-77

Licensed Land Surveyor No. 2853