


CERTIFICATE OF SURVEY
for
Exeter Drilling Co.
Logan County, Colorado



RECEIVED
OCT 20 1964

OIL & GAS
CONSERVATION COMMISSION

T12N R54W 6PM

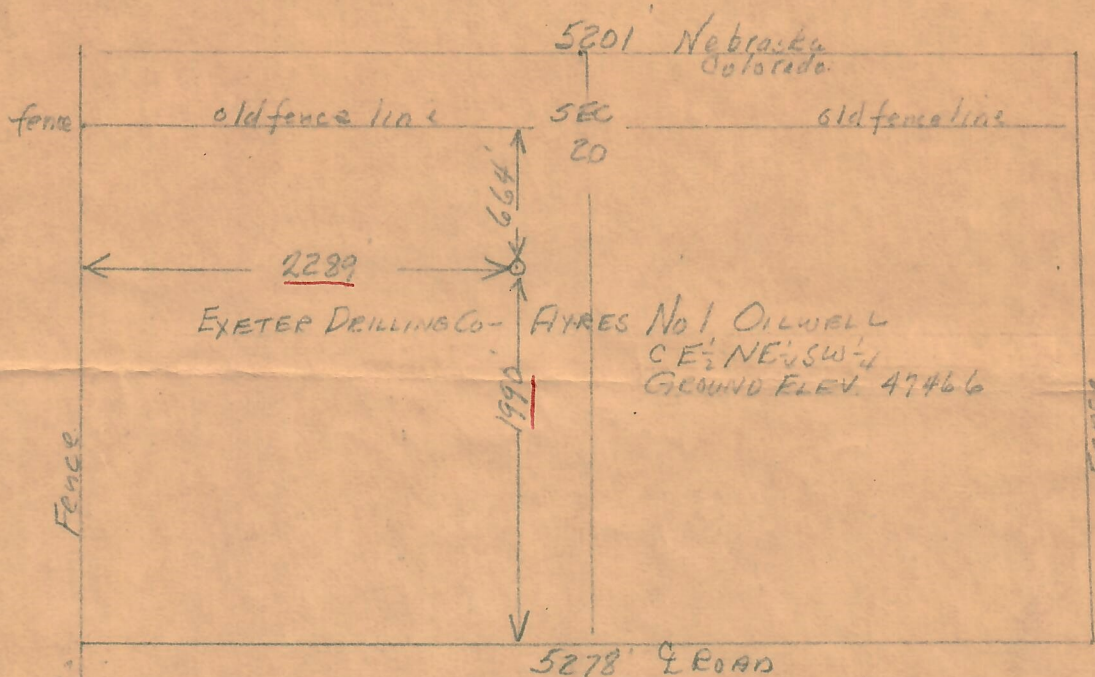

I hereby certify that the above plat is an accurate representation of a correct survey showing the location of Exeter Drilling Co. - Ayres No. 1 Oilwell in C E 1/2 NE 1/4 SW 1/4 Sec. 20 T12N R54W 6PM. The elevation of the ground at the stake is 4746.6 feet above sea level from U.S.G.S. Bench Mark.

Fort Morgan, Colorado
Oct. 14, 1964

David J. Osborne
Registered Professional Engineer
State of Colorado.

64-461